



"SOUTHERN JESTER" Ex. "KJAPP"


PROFILE & DECK PLAN

APPROVED 22-8-52

OSLO REPORT No. 7163

RECORDS DEPT.
LONDON

3

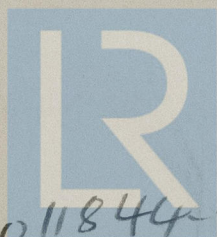

© 2021

Lloyd's Register
Foundation

011844-011850-0112

Drawing No 5 PROFILE & STEEL DECKS SHIP No 1434

SCALE: 1-50

-NOTE-

ALL BUTTS & SEAMS OF MAIN & LOWER
DECK PLATING TO BE WELDED

DIMENSIONS

LENGTH B.P. 145M/147'6" BREADTH MID 9M/29'6"

DEPTH 5.49M/18'2"

ALL DECK BUTTS CENTRE OF DAYLIGHT

-MATERIAL ORDER-






SECTIONS

NO.	LEN	BREADTH	THK	REMARKS
1	18'6"	5'3"	34	OA










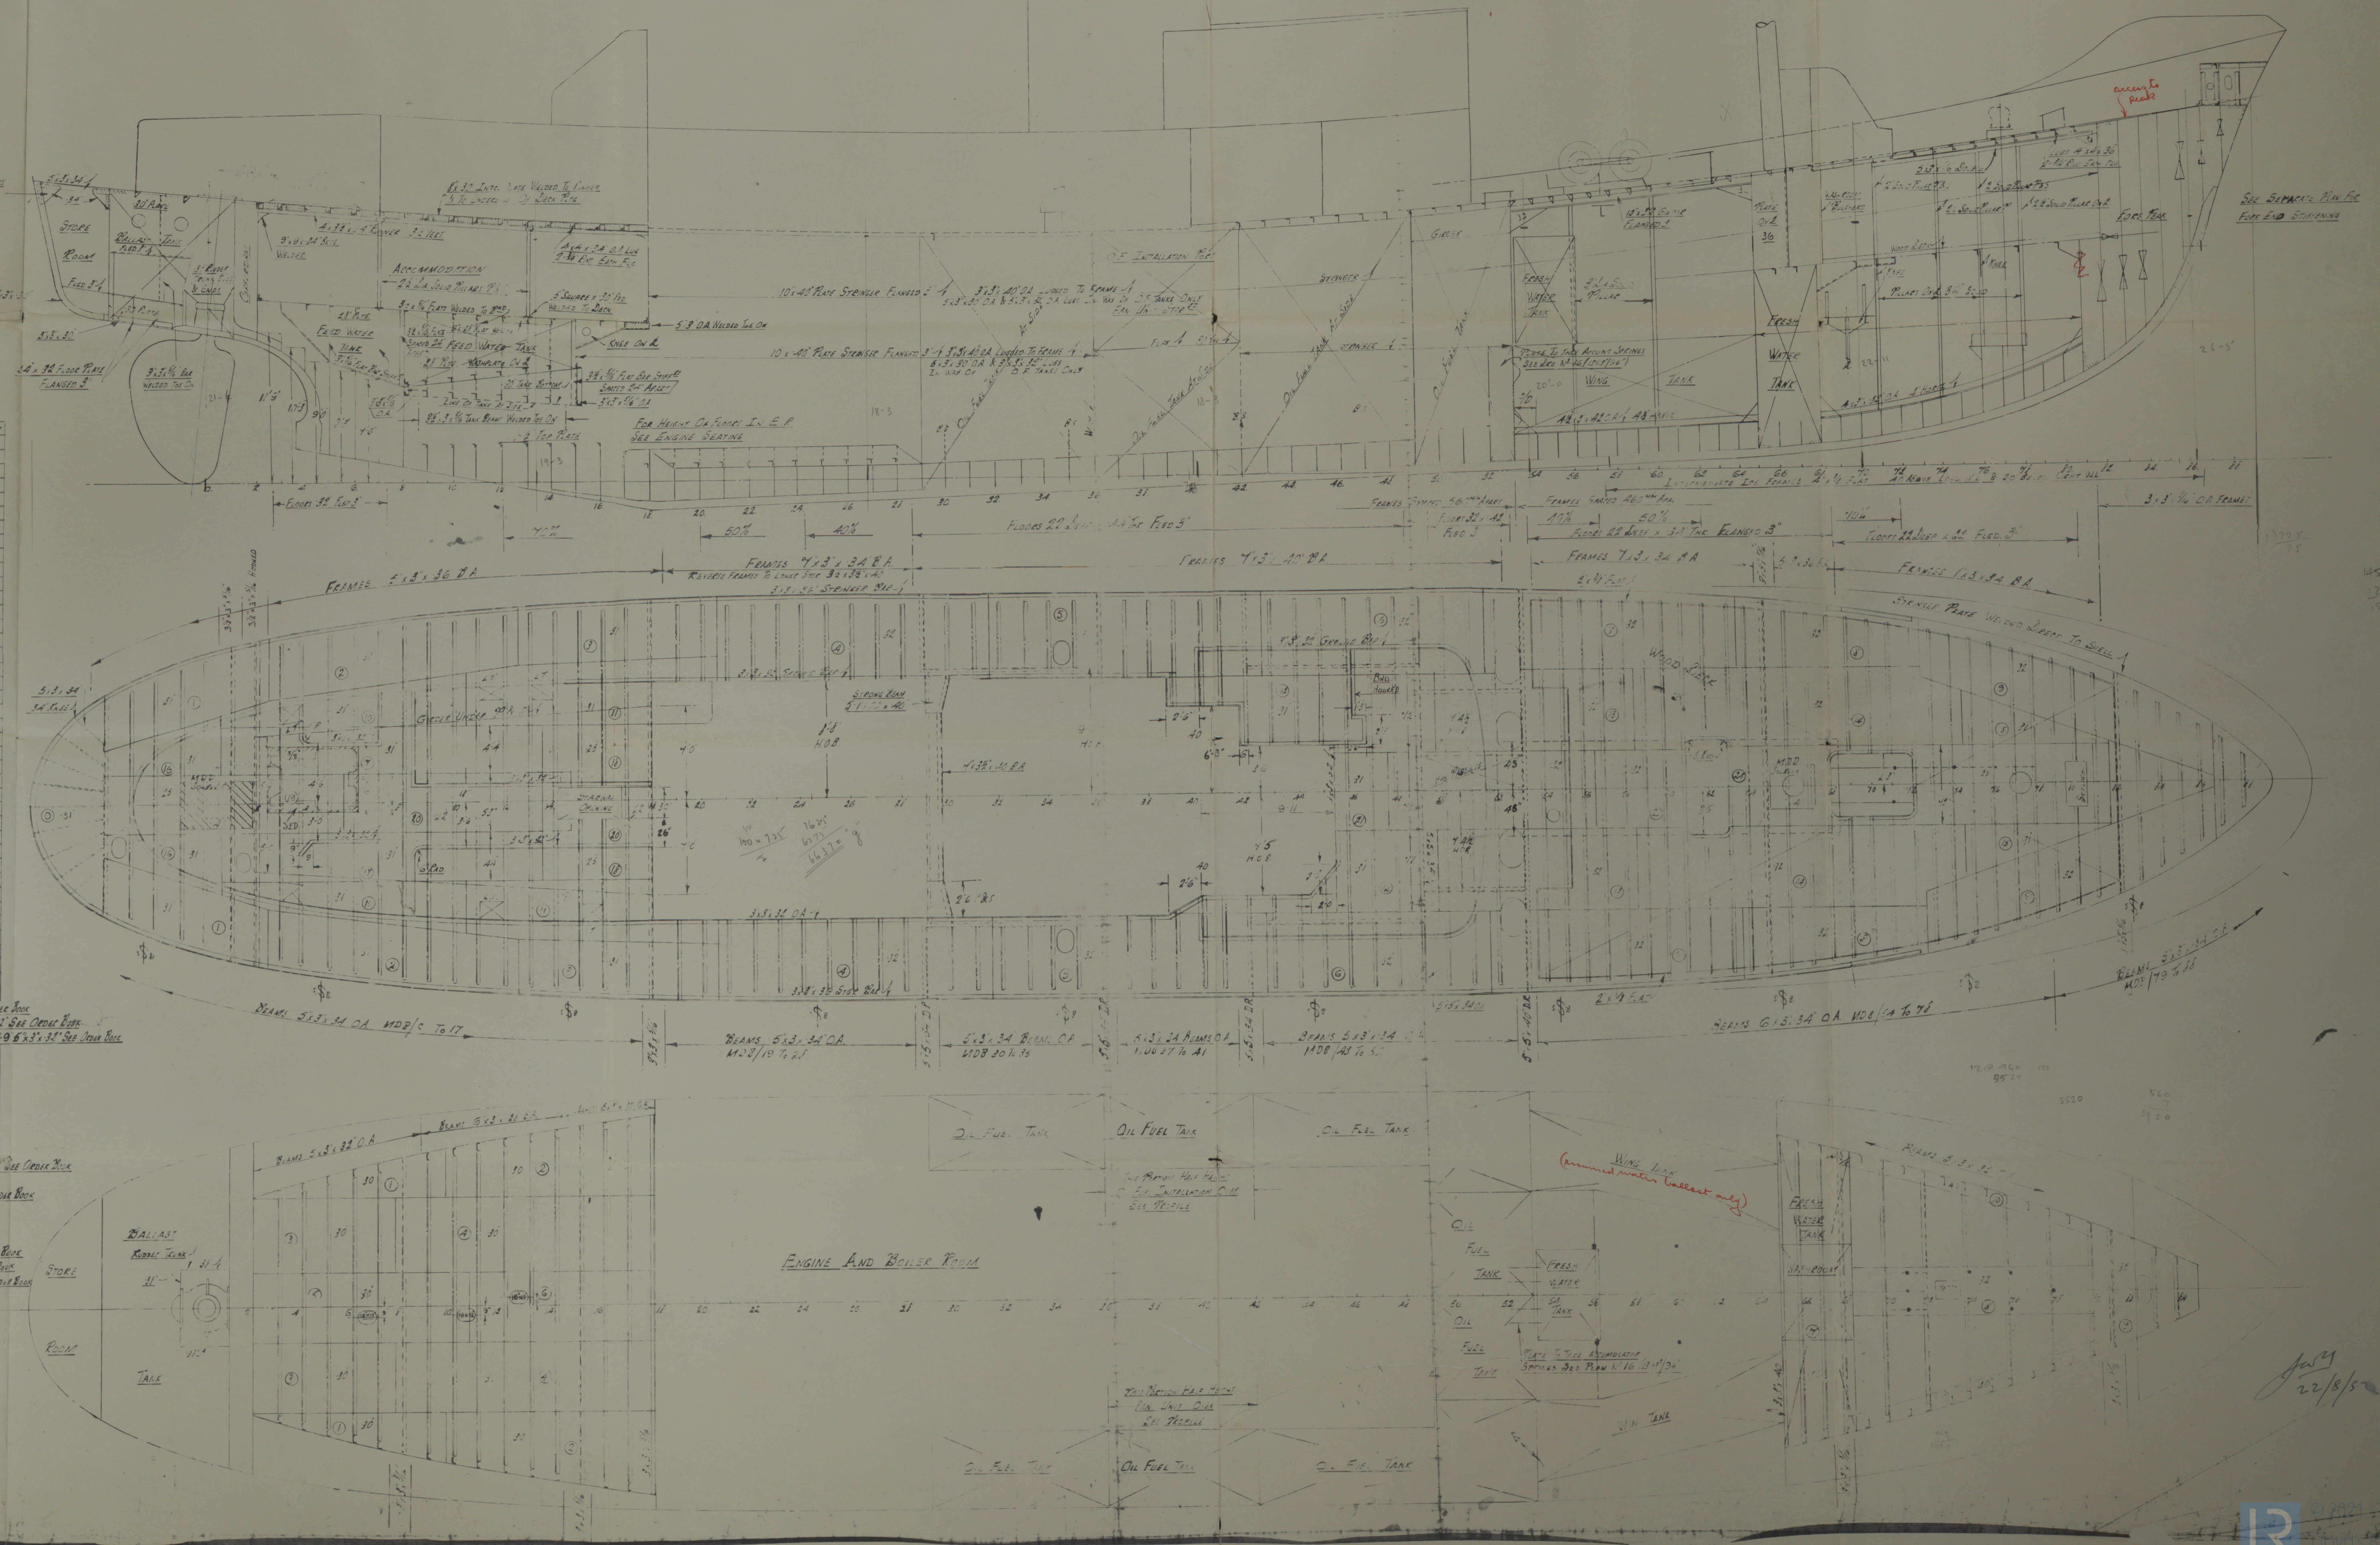

22/8/52

22/8/52

22/8/52

"SOUTHERN JESTER" EX "KJAPP"

MIDSHIP SECTION

APPROVED 22-8-52

OSLO REPORT No. 7163

RECORDS DEPT.
LONDON

2



© 2021

Lloyd's Register
Foundation

011 844-011850-0111

62 L = 1240 wt = 63,000 lbs.



© 2021

Lloyd's Register
Foundation

SHIP Nº 1434^P

MIDSHIP SECTION

SCALE :- $1/2" = 1$ FOOT.



TRANSVERSE NUMERAL $15.75 + 18 + 25.42 = 61.17$
 LONGITUDINAL NUMERAL $167.46 + 61.17 = 902.62$
 BOTTOM NUMERAL 902.62
 MEELON NUMERAL $902.62 \times \frac{2.45}{30 \times 3.25} = 2755.84$
 EQUIPMENT NUMERAL $902.62 + 97.66 + 77.25 + 40.83 = 7.25 + 10046.447$
 FRAMING d $= 16.16$
 TOPSIDE NUMERAL 902.2

EQUIPMENT "WHLER."				
1 BOW	ANALOR	WEIGHT	EXCLUDING STOLN.	= 8% CWT.
1	"	"	"	= 8% CWT.
1 WARP	"	"	"	= 5% CWT.
180	FATHOM	1 3/4"	DIA SHOOT LINK	CABLE
77	"	2 3/4"	GIRL WIRE	ROPE
77	"	2 3/4"	GIRL	"

FOR ICE STIFFENING SEE SHELL EXPANSION.


<u>MEASUREMENTS</u>		
LENGTH B.P.	= 45.0 M.	= 147'-8"
BREADTH MLD	= 9.0 M.	= 29'-6"
DEPTH MLD	= 5.49 M.	= 18'-0"

CLASS ~~✠~~ I. A. I BY NORSKE VERITAS, WHALER.

100 AI "whales"
"strengthened for navigation in Ice"


22/8/51

011844-011850-0111

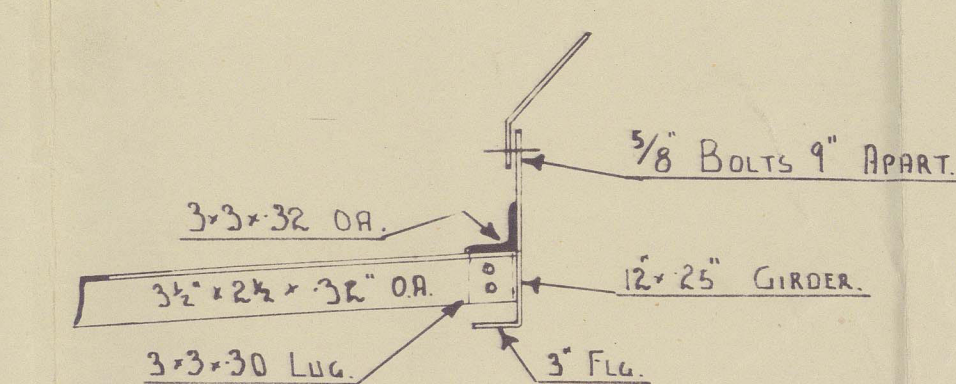

SECTION THRO' ENGINE ROOM SKYLIGHT.




STIFFENERS RIVETTED AND SPACED 2'-3" TO 2'-4"
APART IN ENGINE ROOM CASING.
AND BOILER ROOM CASING

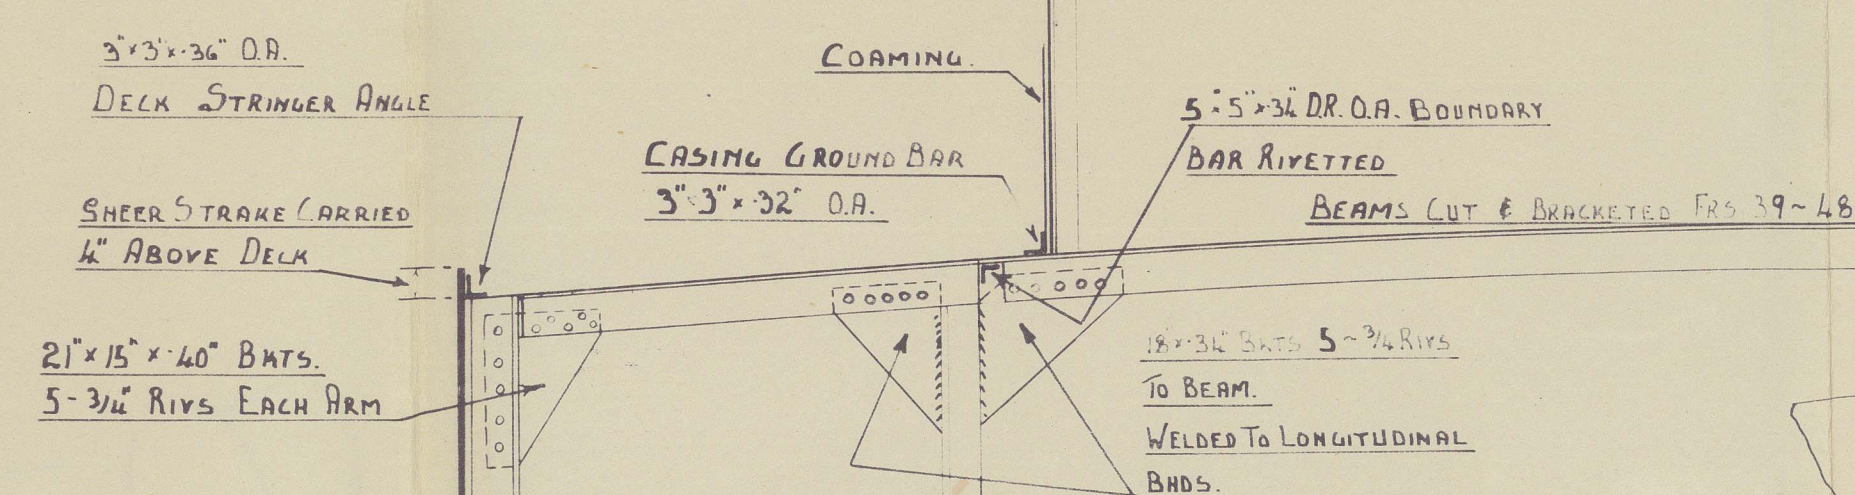

FARMING LIST	
FRAME SPACING	O - 53 = 22"
"	53 - STEM = 18"
"	= 19 1/4"
d FOR FRAMES	O - 18 = 5'3" 36 B/A
FRAMES	19-28 54-64 69-81 = 7'3" 36 B/A
"	29-52 = 7'3" 40 B/A
"	66-68 = 5'3" 36 B/A
"	82-STEM = 3'3" 40 B/A
INTERMEDIATE ICE FRAMES	51/2 To 8 1/2 = 4' 1/2 Flat B/A
"	40' ABOVE LOAD WL. = 2' 2" BELOW LIGHT WL.
REV FRS TO LOWER STRINGER	10 To 28 = 3'6" 1/2 x 40'



RIVETING LIST.				
LOCATION	DIA OF RV	DIA OF PART	DIA INCHES	REMARKS
RIVETS THRD STEM & KEEL	1"	DIA KEEL		
" " FRAMES & FLOORS	3/4"	7" PART	5 1/2"	
" " " & SHE	3/4"	7" PART	5 1/2"	1 1/2 DIA OF DEEP THINS 5/8 DIA OF PART
STR ^{GS} RIVETS BOTH FRAMES	3/4"	4 1/2"	3 1/2"	WELDED
SHELL BUTTS	-	-	-	
DECK STRINGER BUTTS	-	-	-	
" BUTTS	-	-	-	
" SEAM	-	-	-	

NOTE:- ALL SHELL SEAM $\frac{3}{4}$ " DIA RIVETS, 6 RIVETS IN EACH ROW
EXCLUDING FRAME RIVETS 1 RIVET THROUGH FRAME &
SEAM NEXT RIVET AS NEAR AS POSSIBLE TO JOGLE

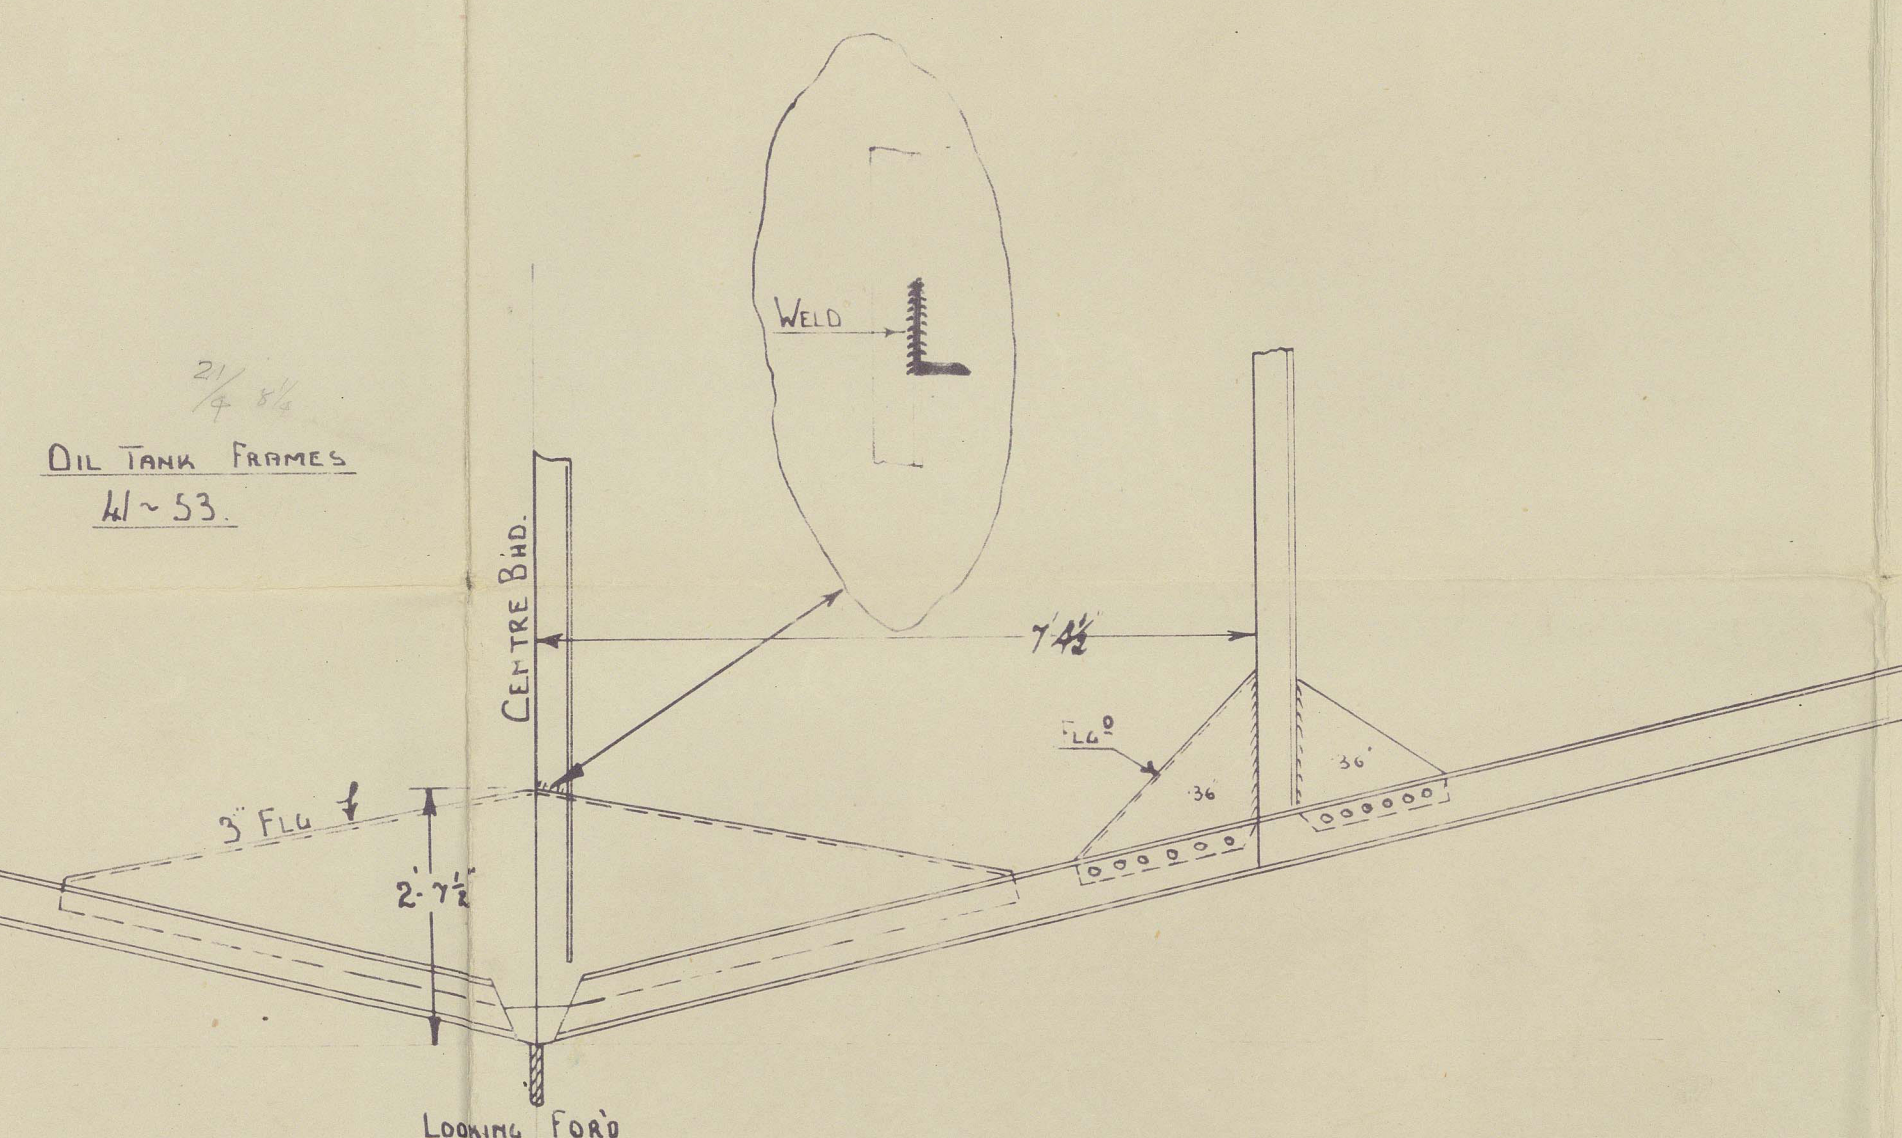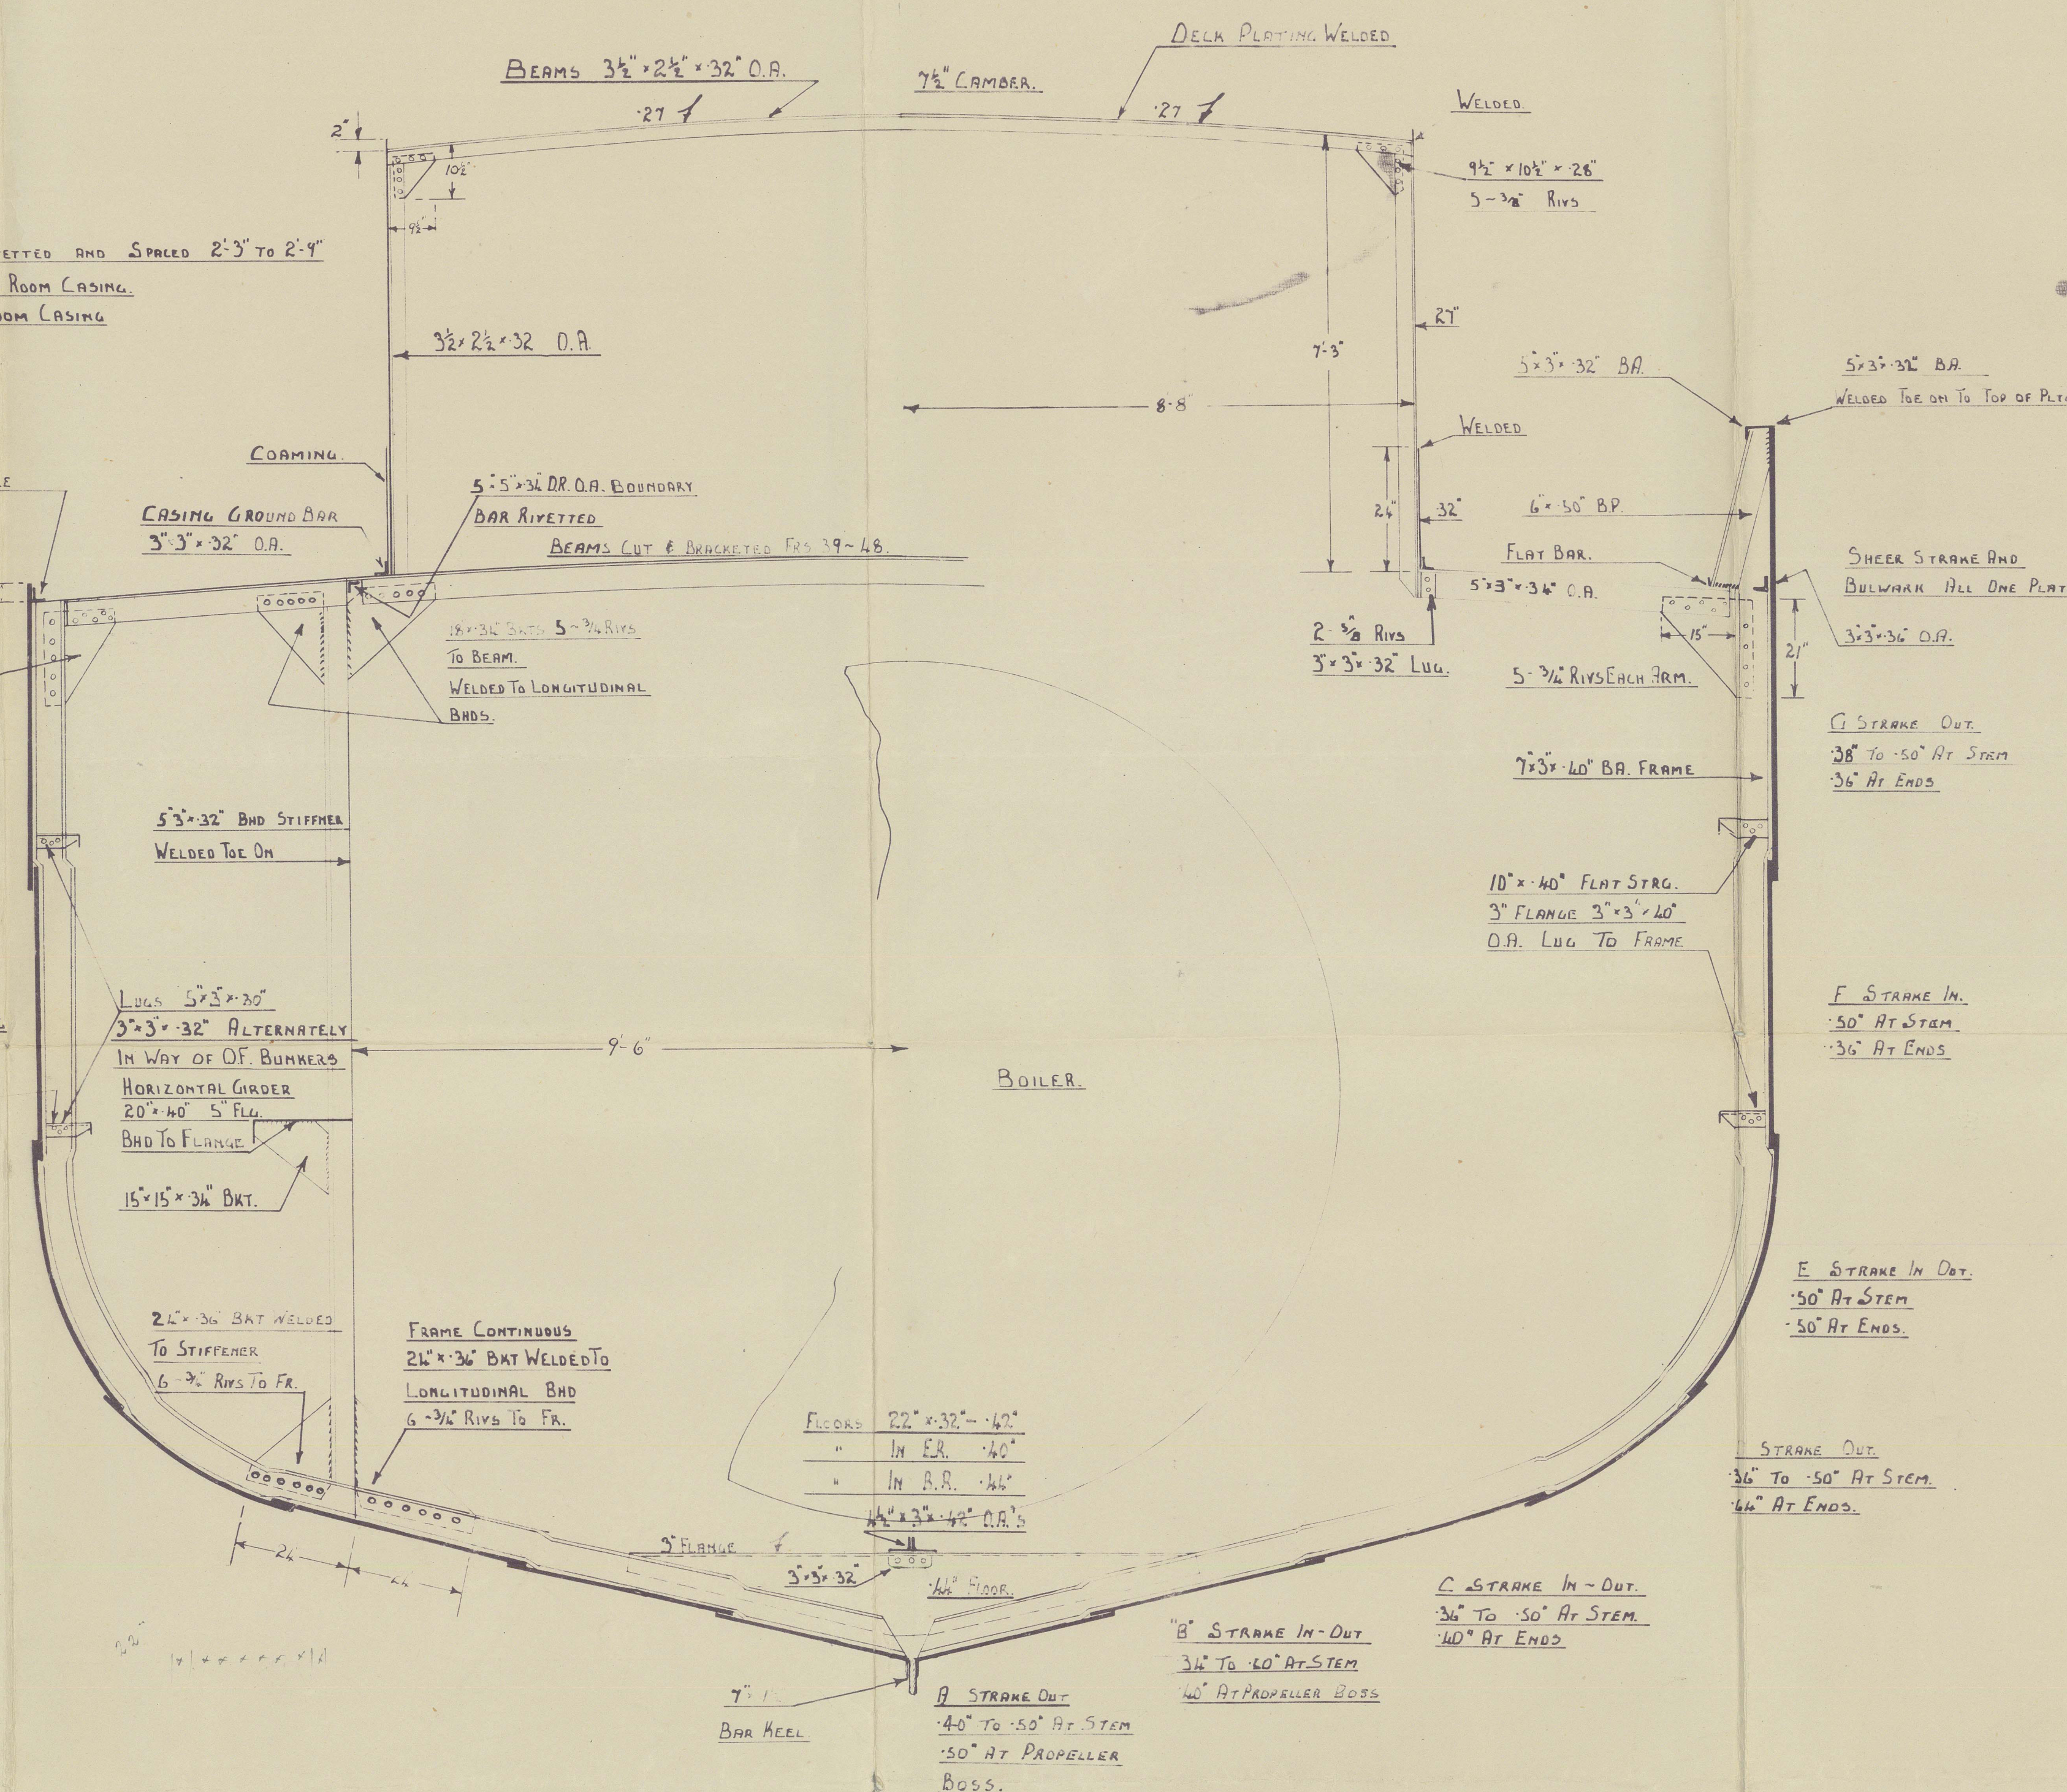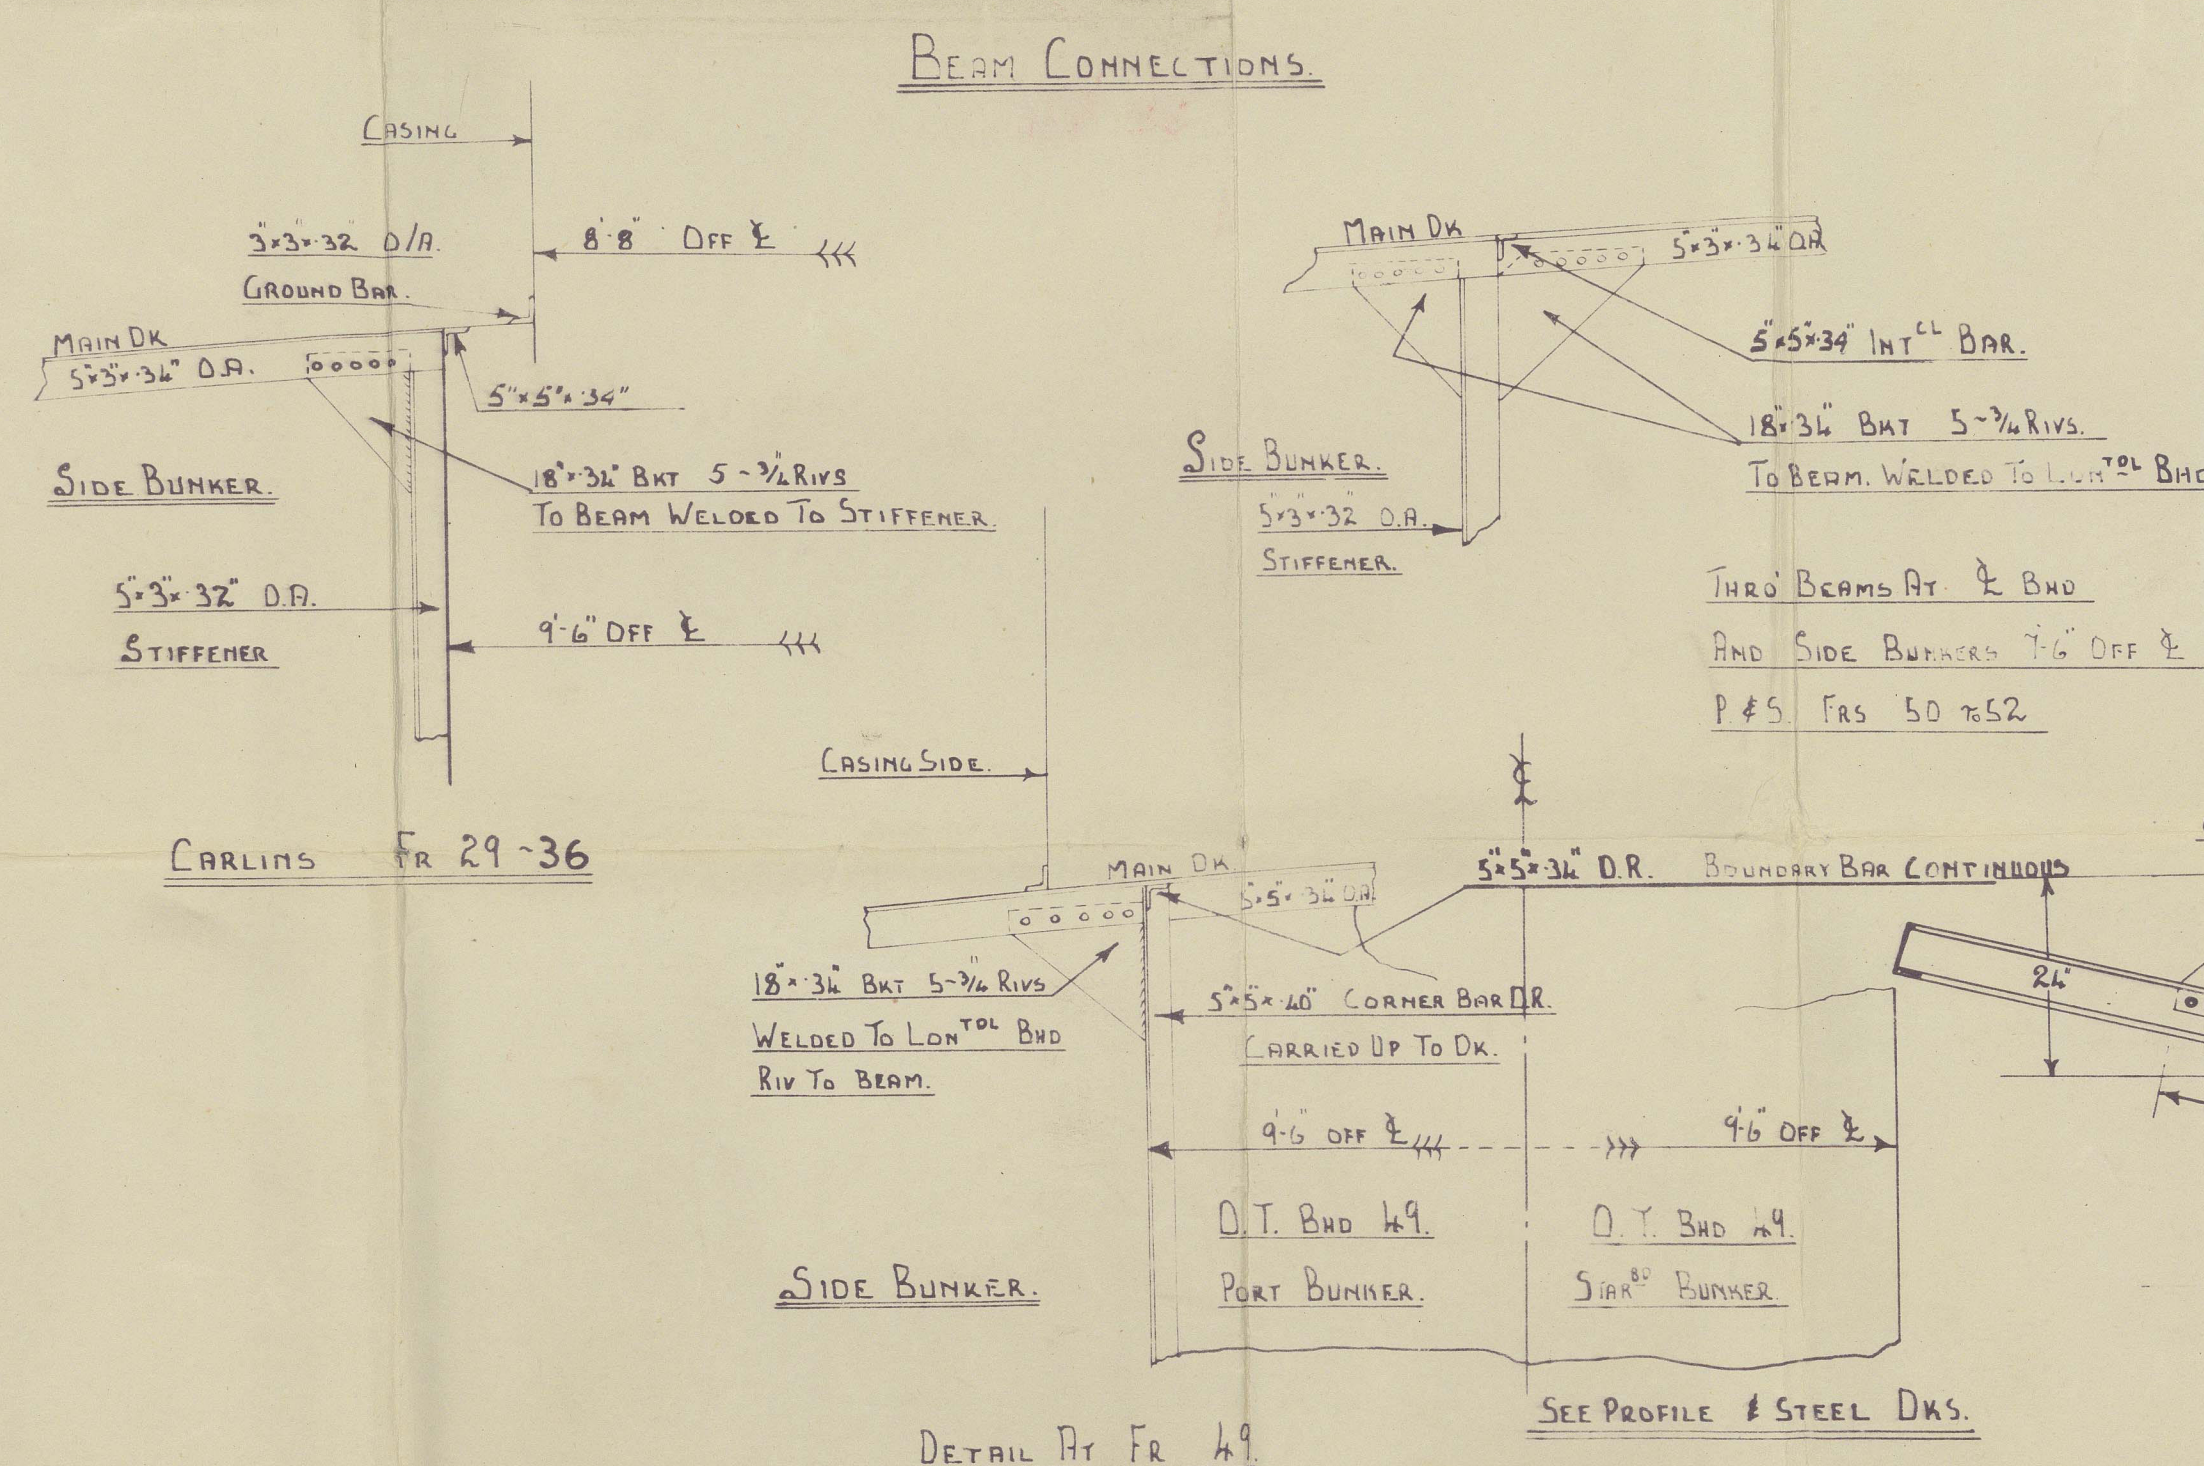

Southern Jester
Ship board


RECORDS DEPT.
LONDON

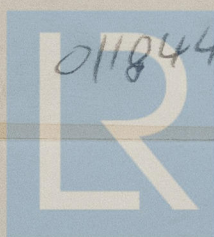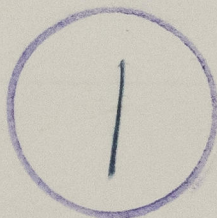

011844-011850-0110


Lloyd's Register
Foundation

LONDON COPY

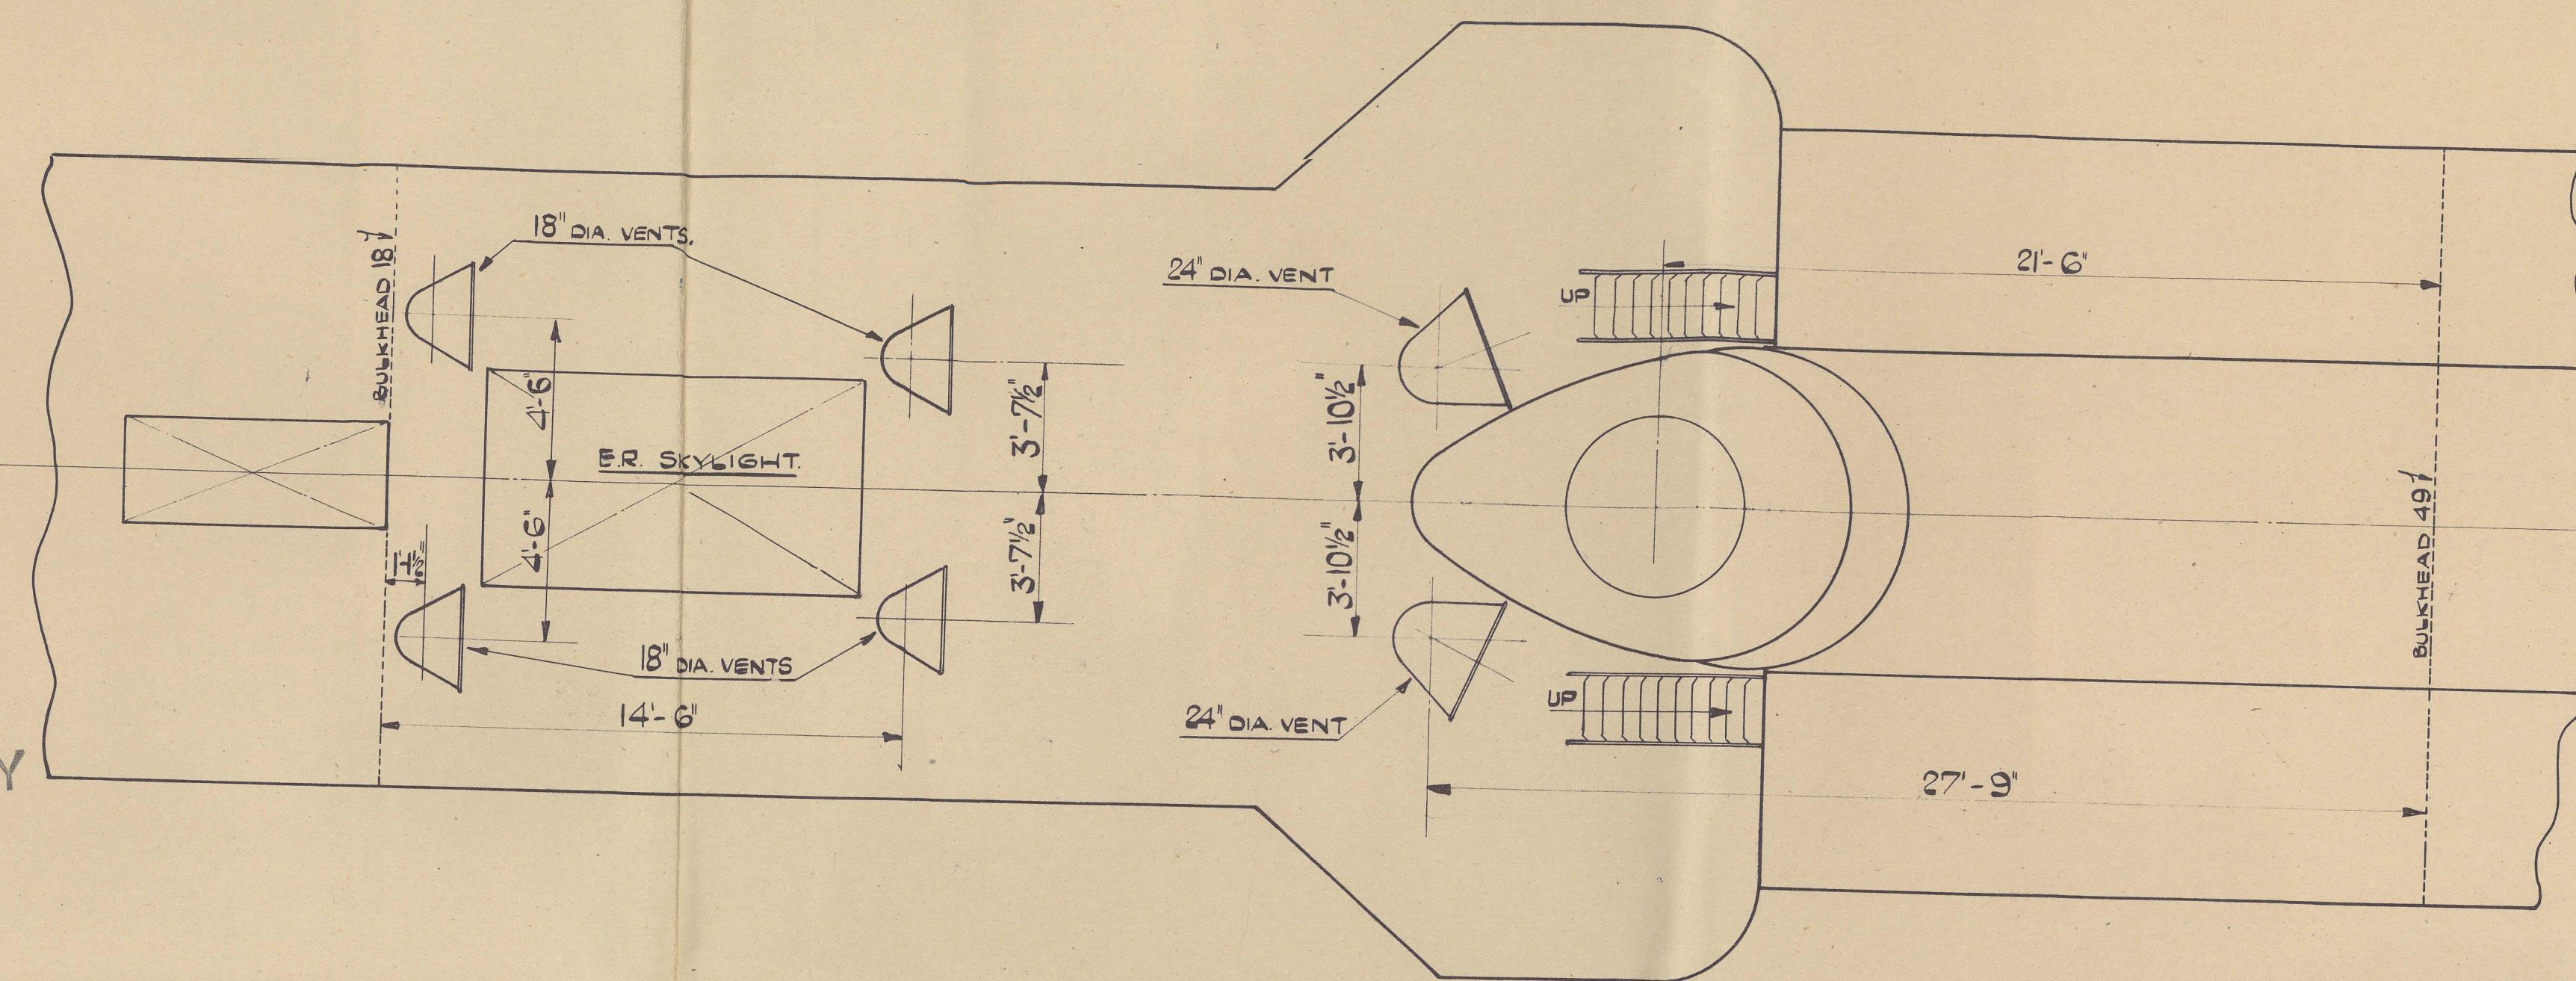


NOTE:- OUTER FUNNEL BY SHIPBUILDERS
INNER FUNNEL BY RANKIN & BLACKMORE LTD


LONDON COPY

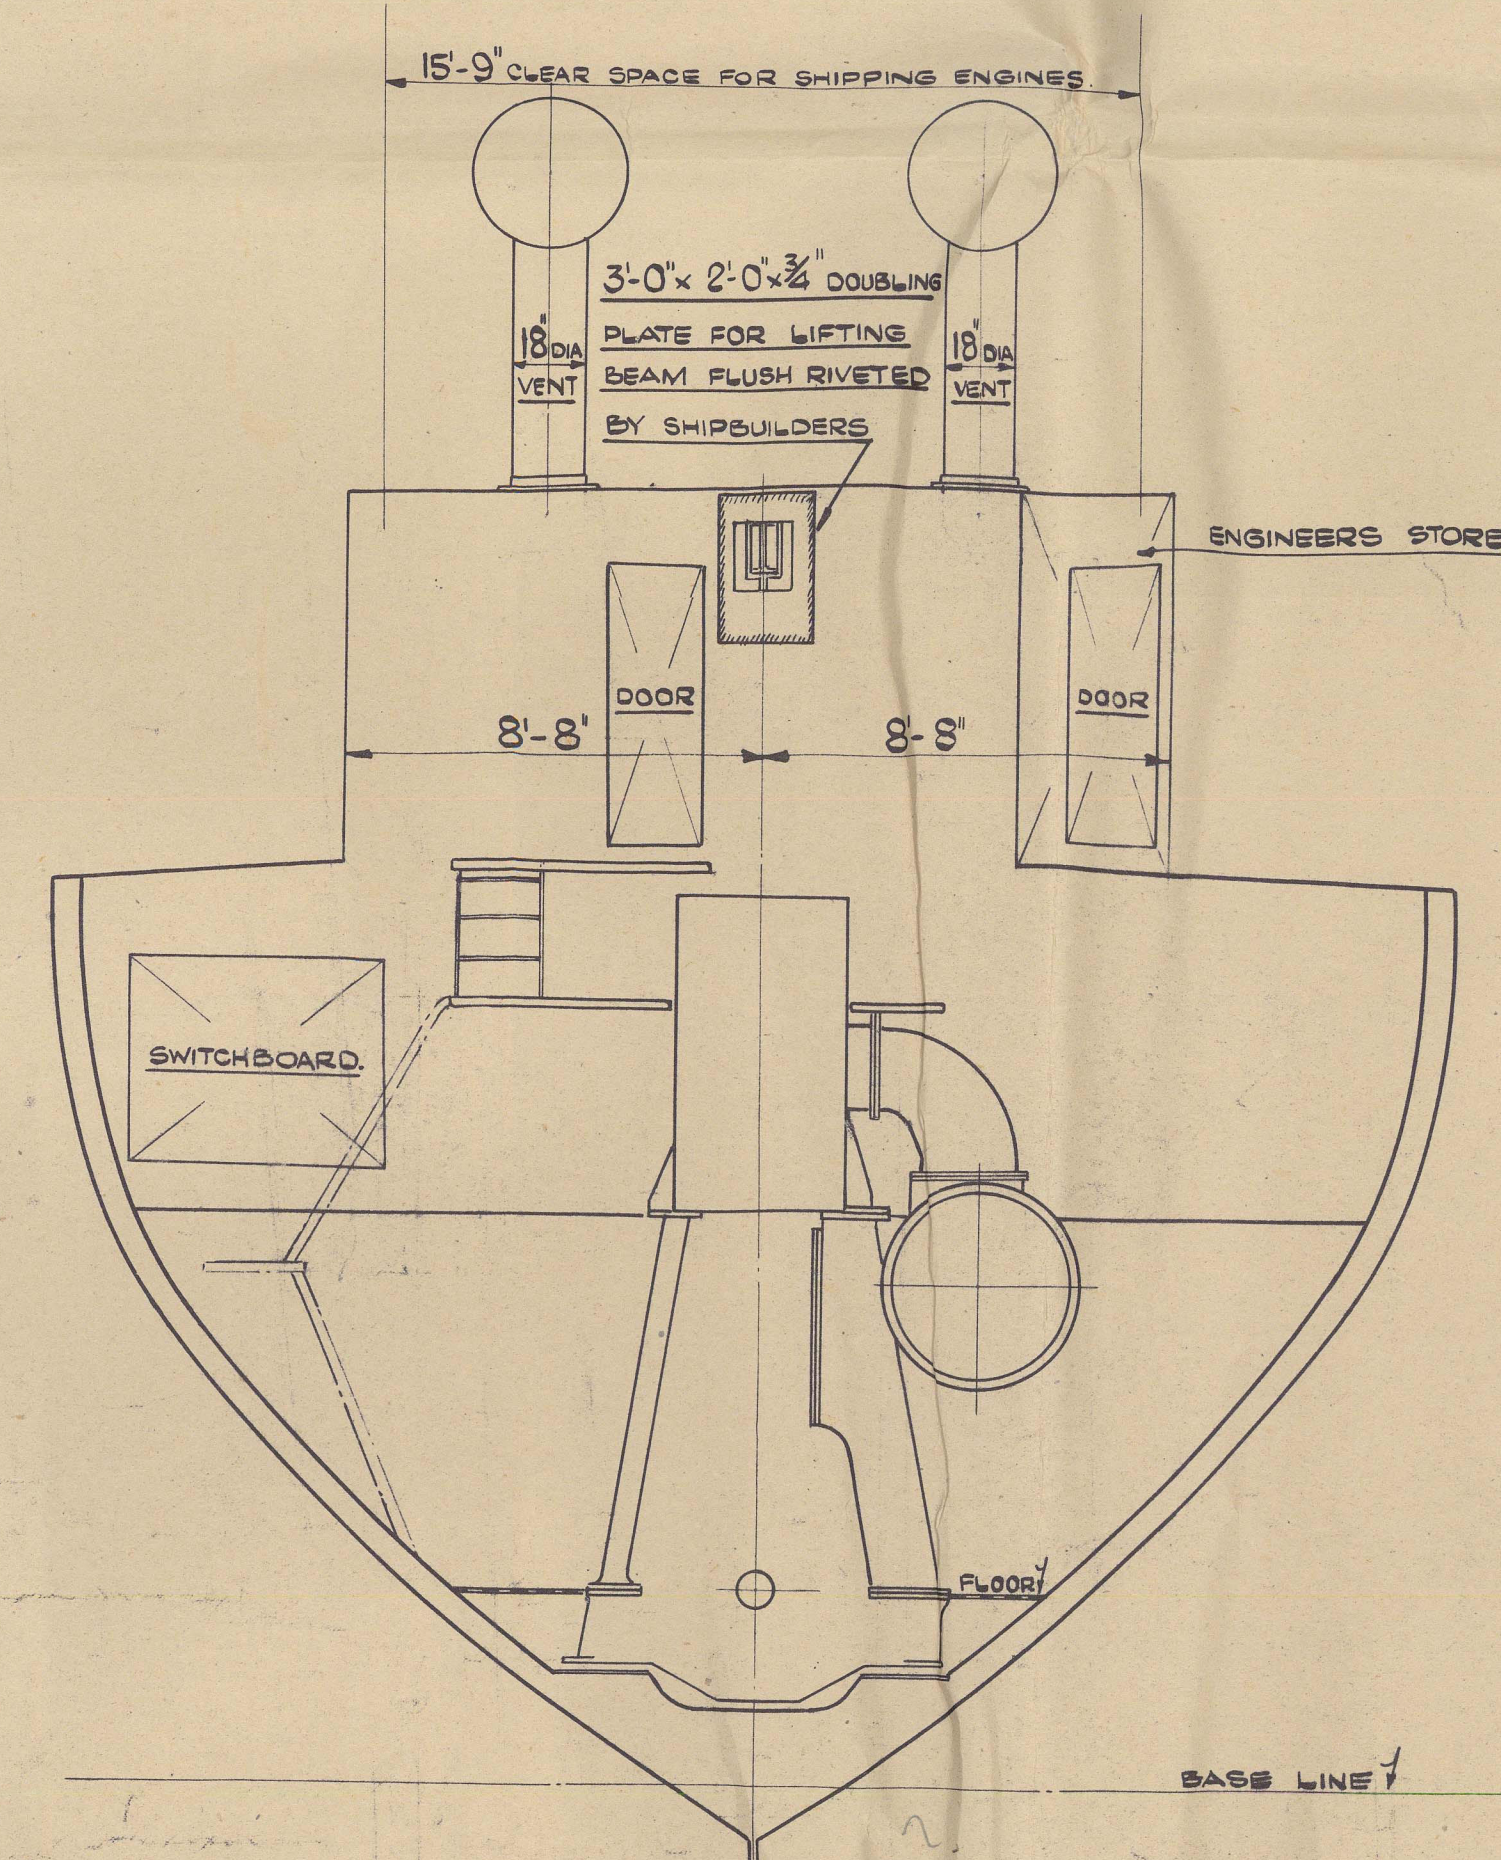

SECTION AT FRAME 18 - LOOKING AFT.

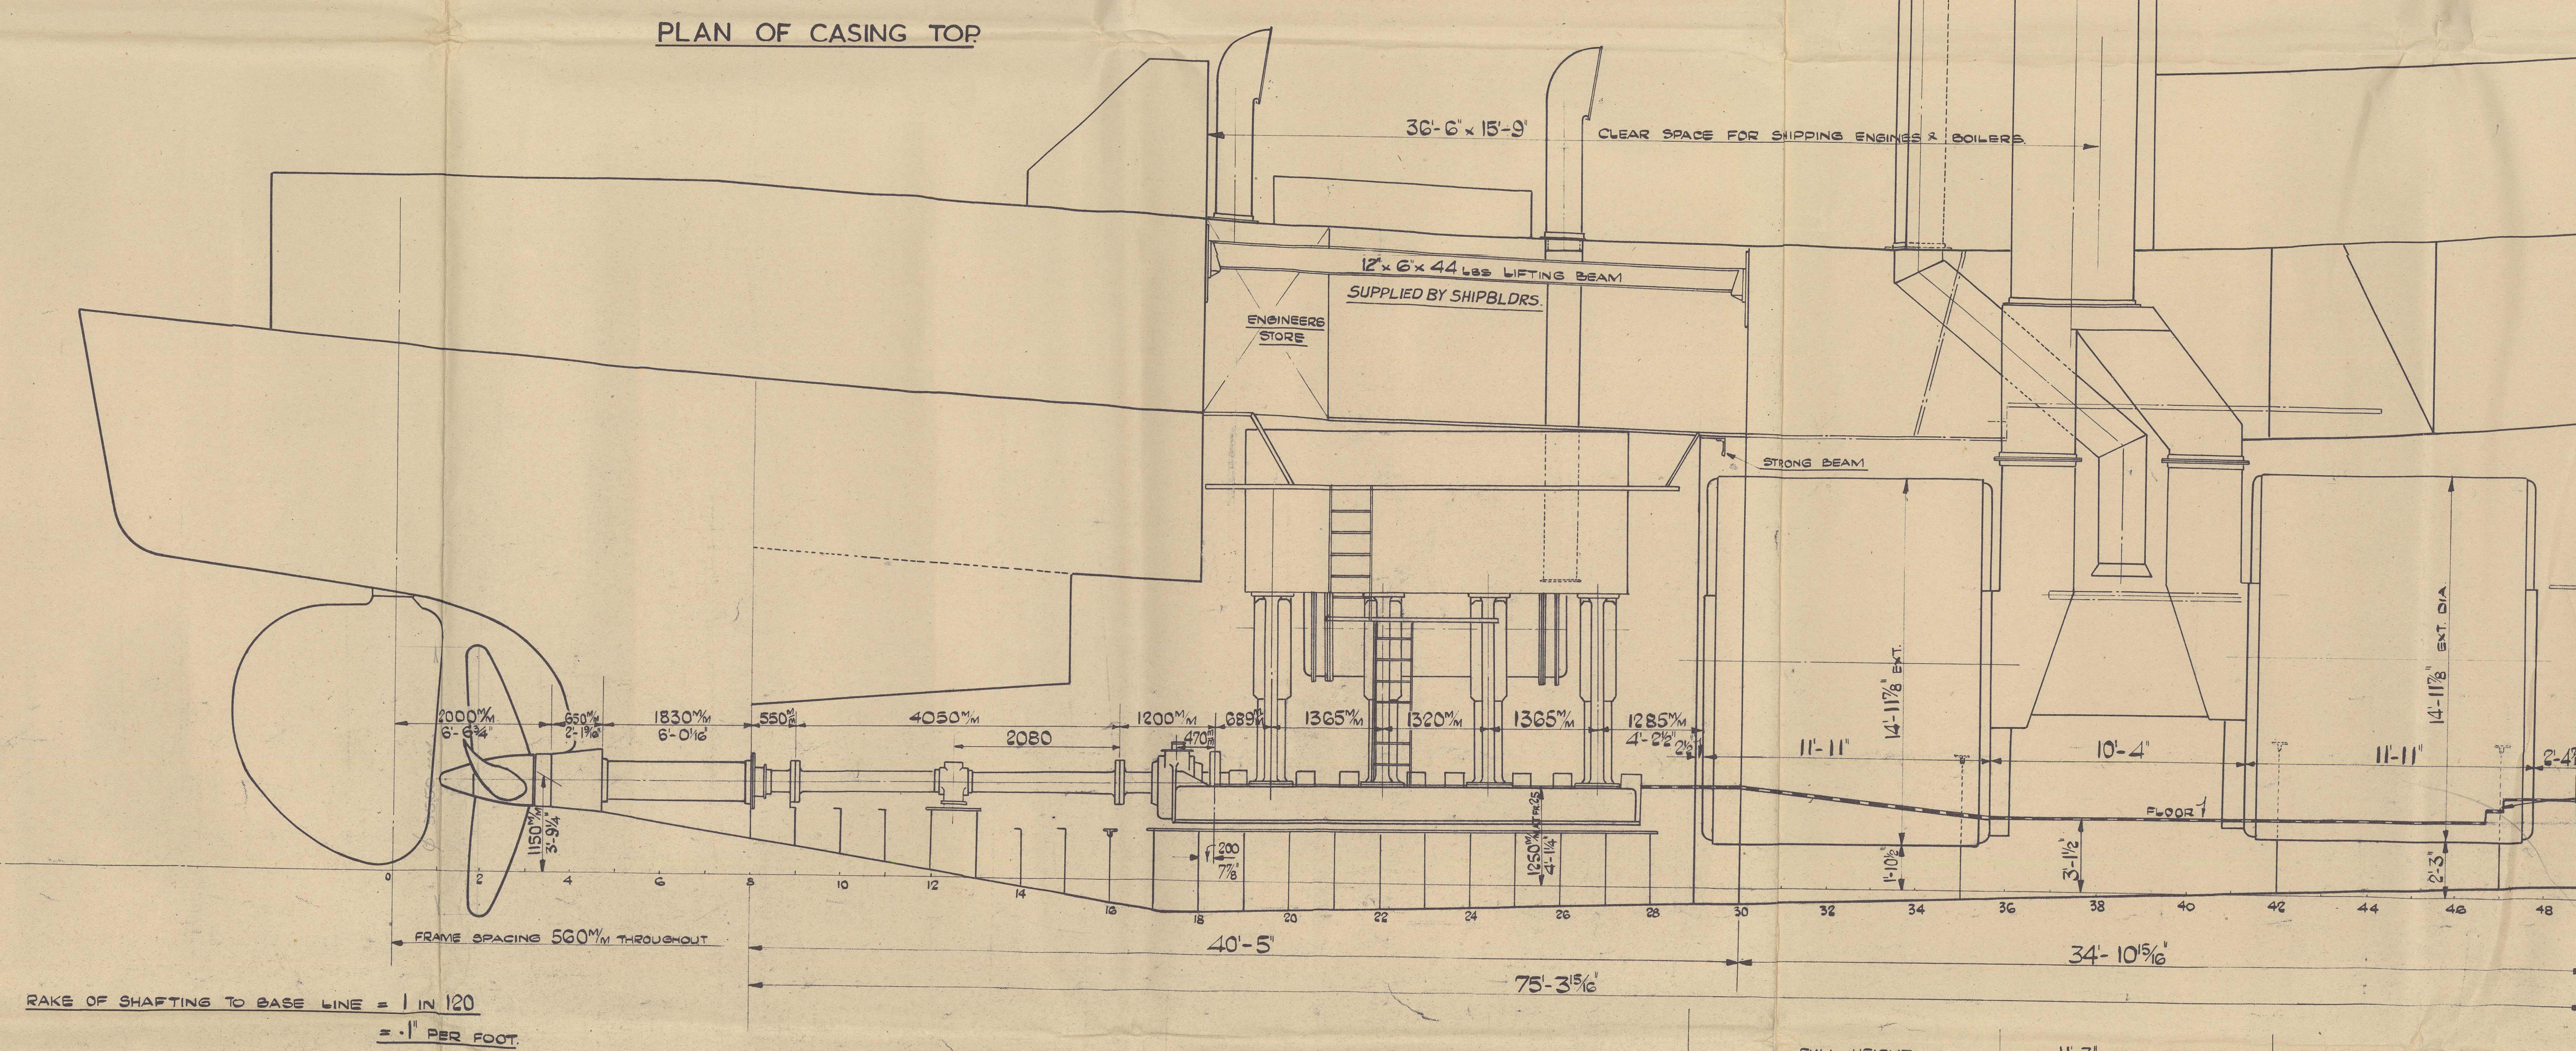



SECTION AT FRAME 8-LOOKING AFT.

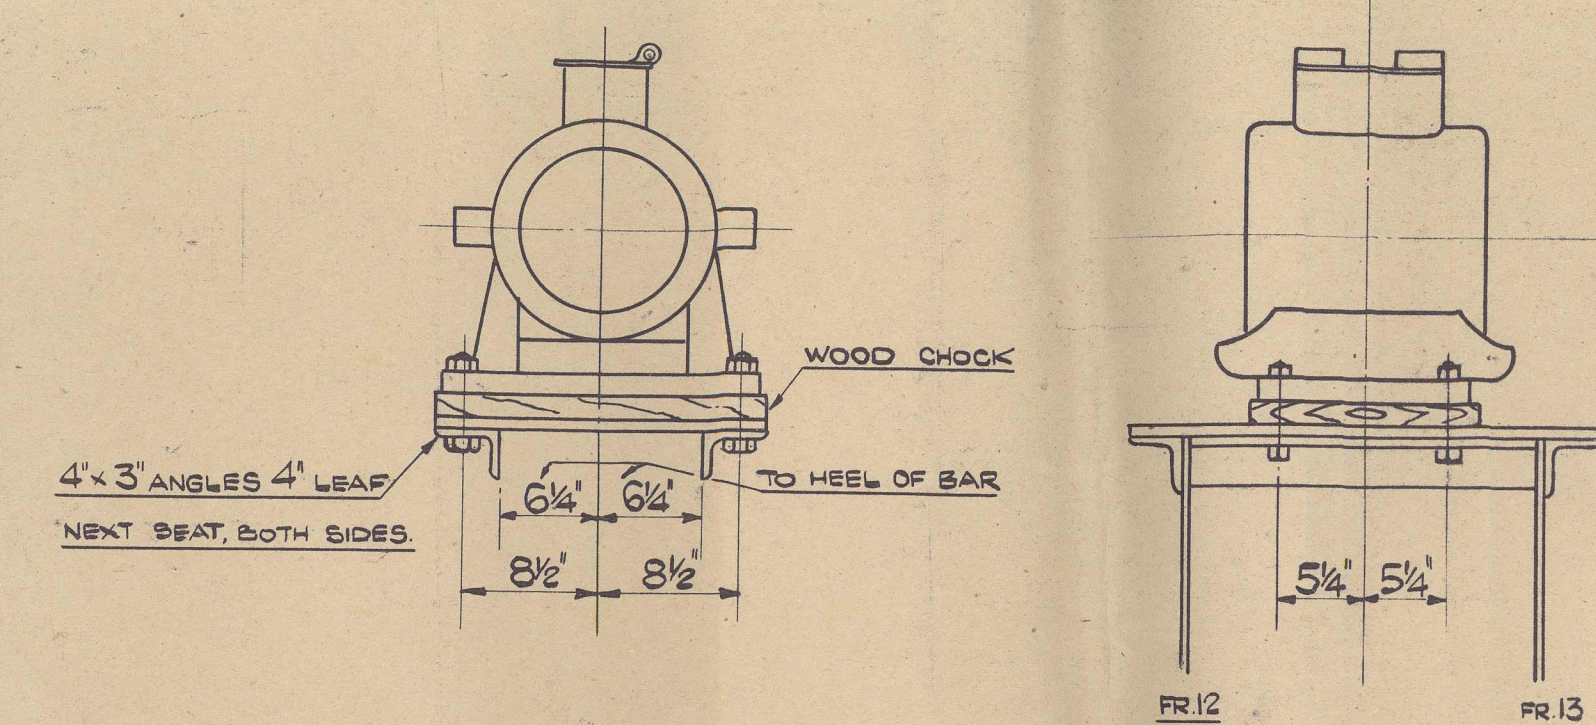


SCALE:-1"=ONE FOOT.

DETAIL OF SEAT FOR INTERMEDIATE SHAFT

PLUMMER BLOCK.

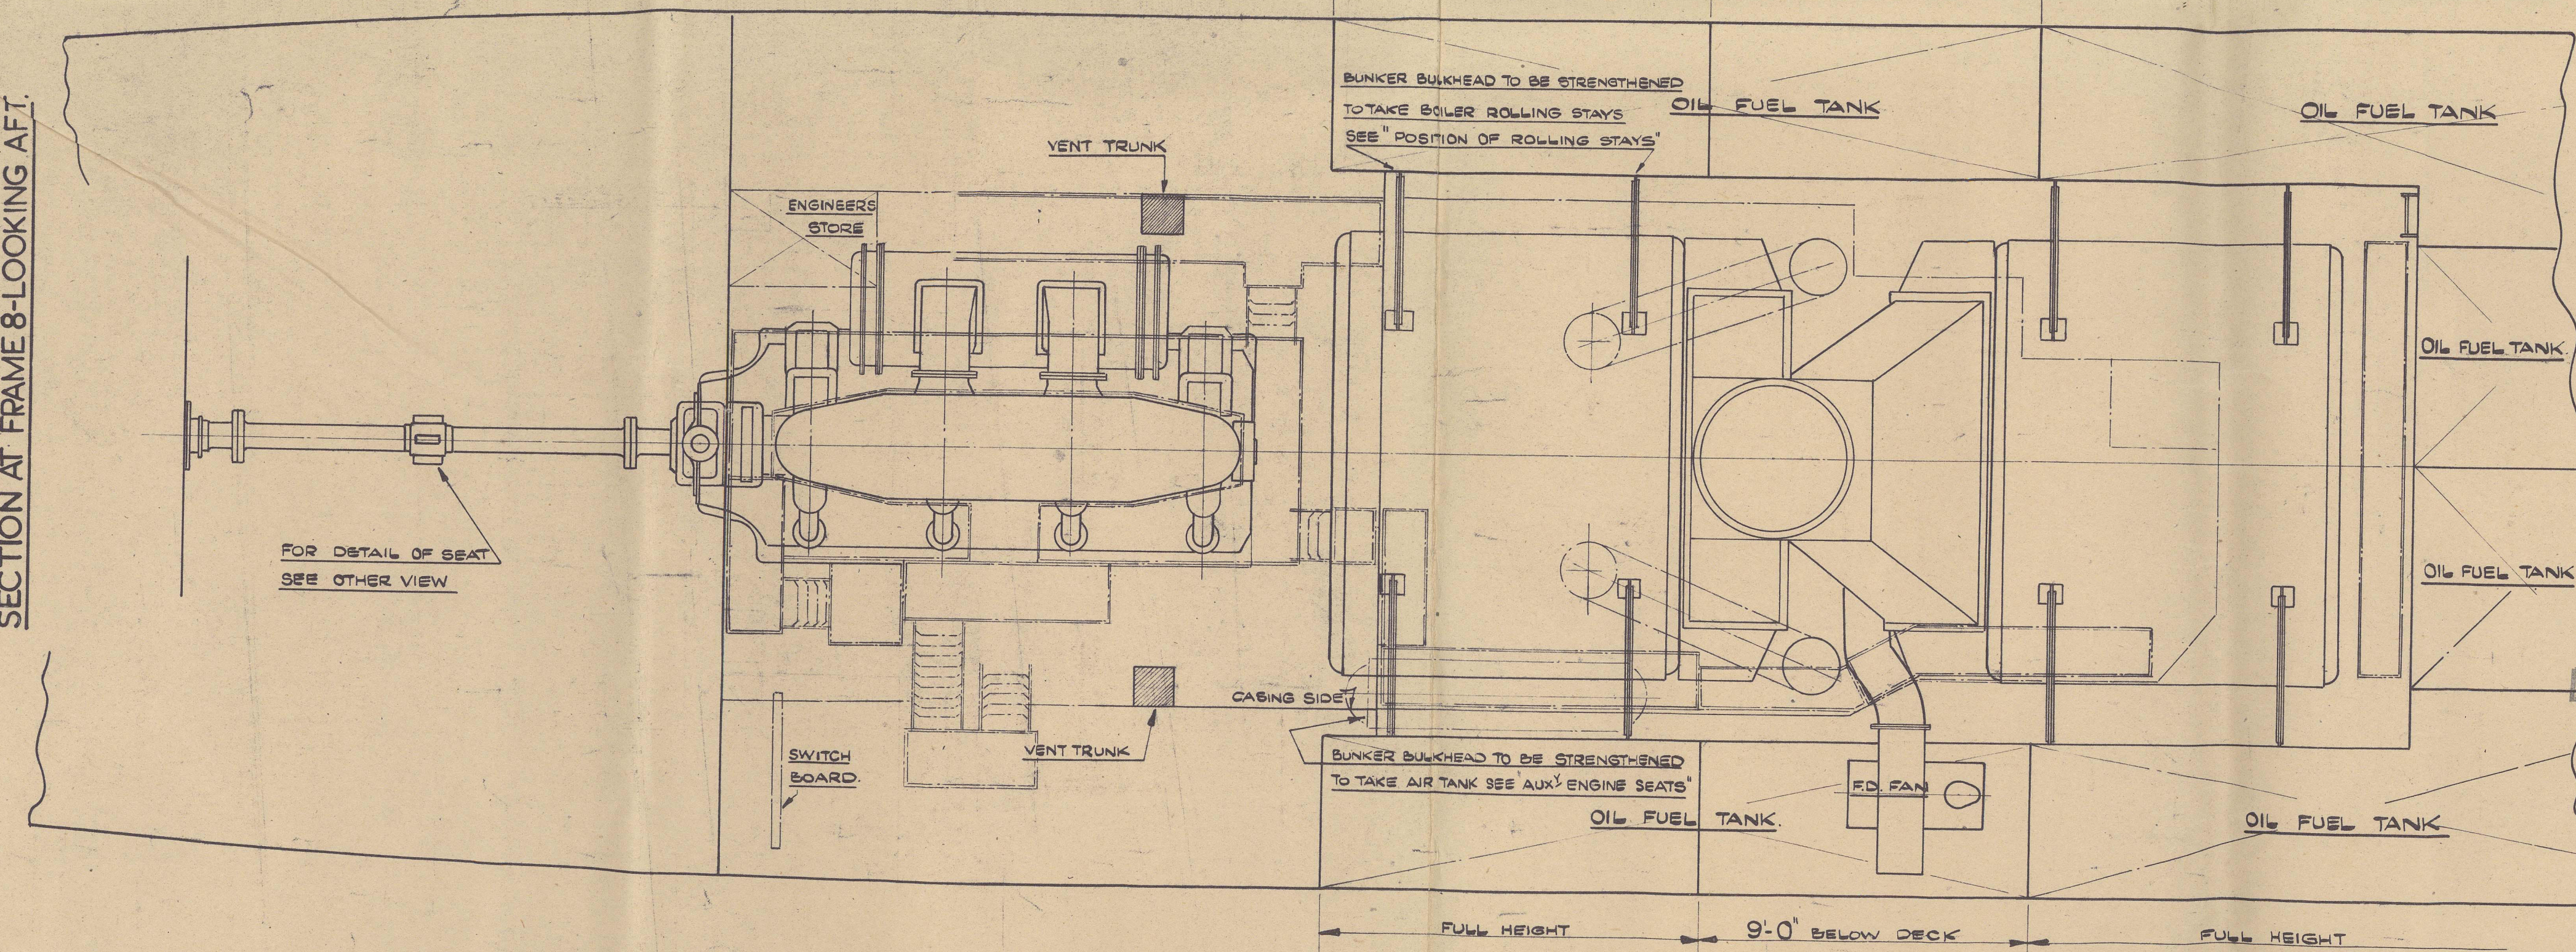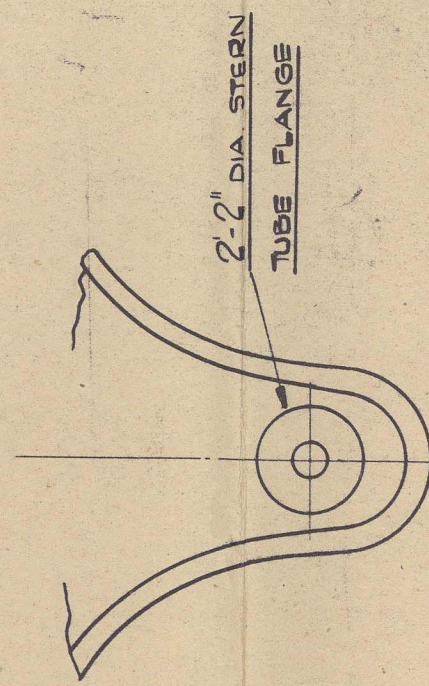

SECTION AT FRAME 29-LOOKING FOR

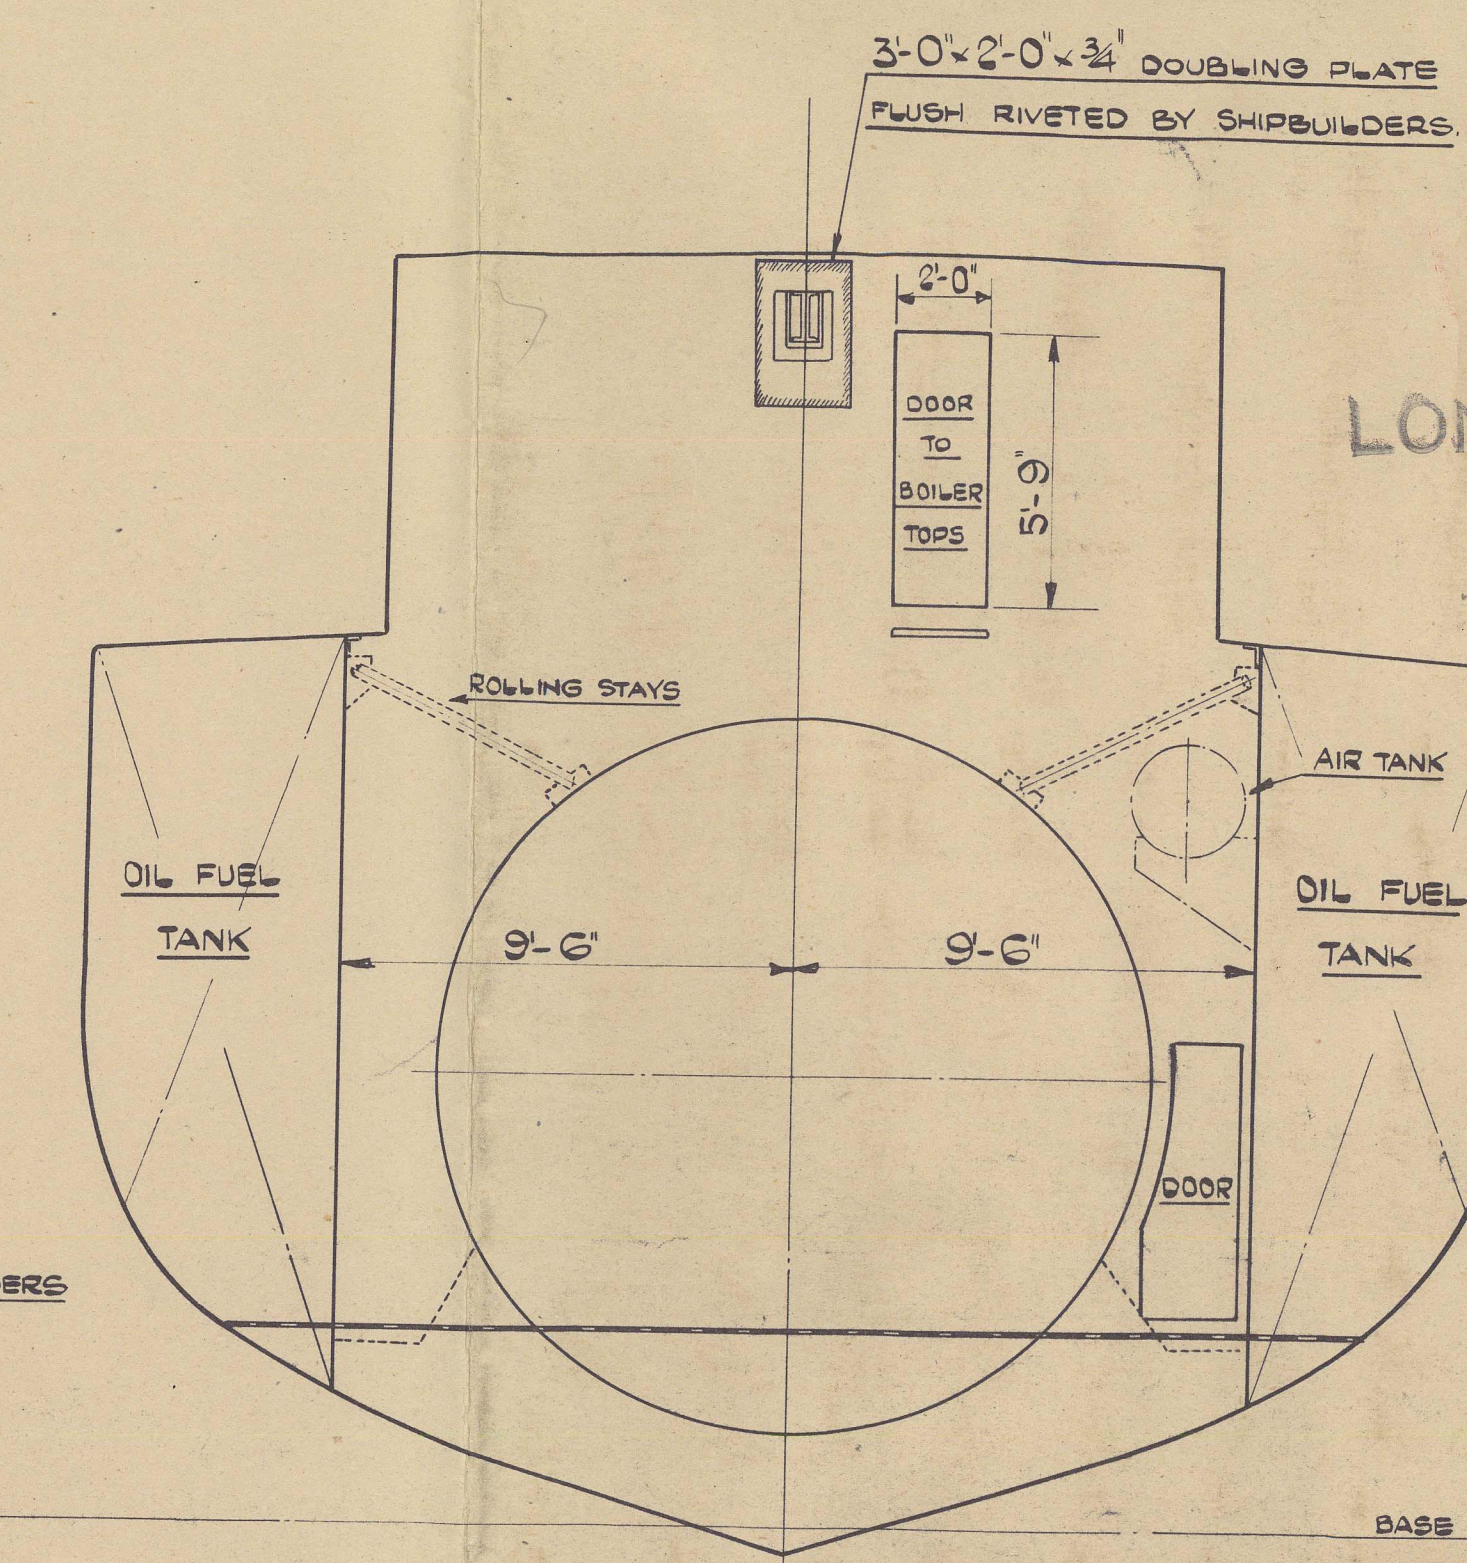


SECTION AT FRAME 38-LOOKING FOR

SCALE:-1/4"=ONE FOOT.

SHIP ARRANGEMENT.

ENG.No.544. SHIP No.1434^P


LONDON COPY

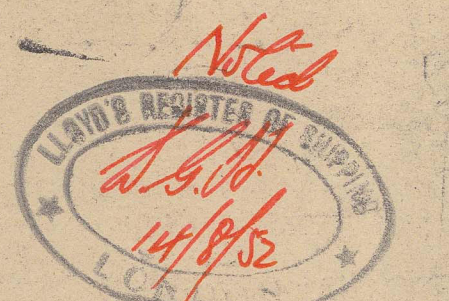

RECORDS DEPT.
LONDON

4

Southern Jester
Sternframe

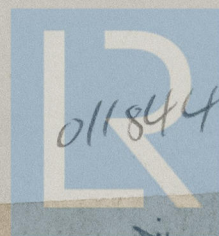


© 2021


011844-011850-0114

Lloyd's Register
Foundation


SOUTHERN
JESTER

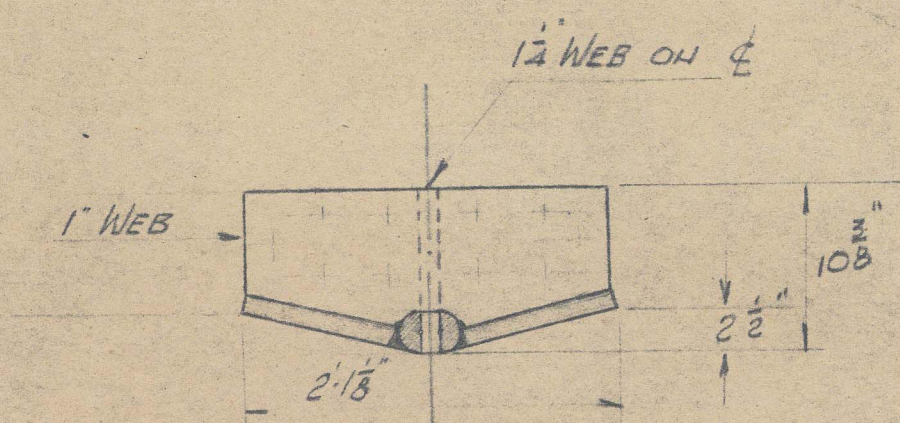


SECTION AFT FR 2
LOOKING AFT

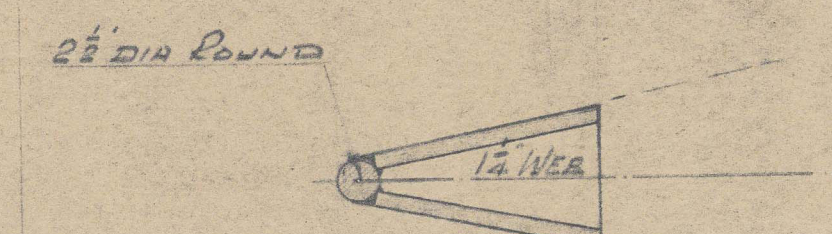


SECTION 6'-2 $\frac{3}{4}$ " ABOVE BASE

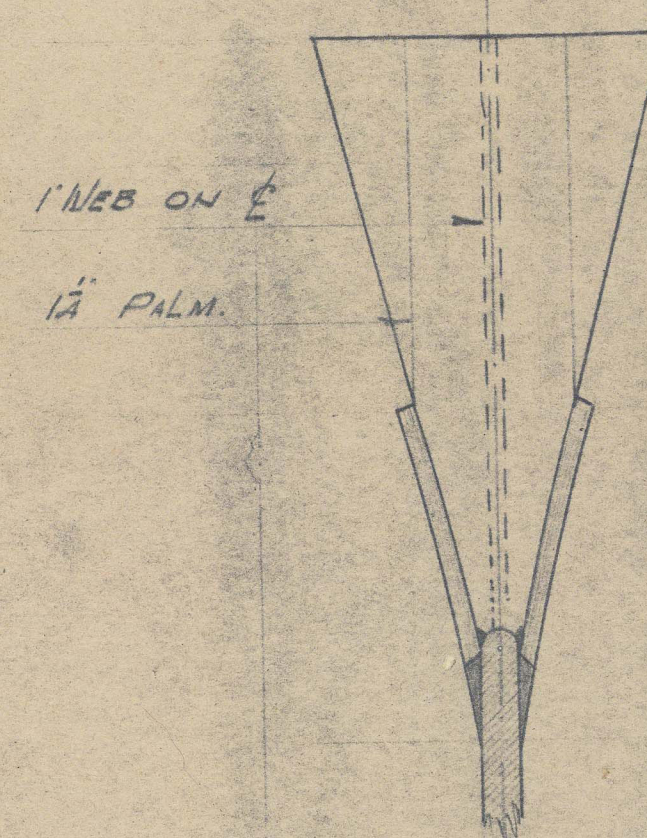


SECTION AFT FR. 4
LOOKING AFT

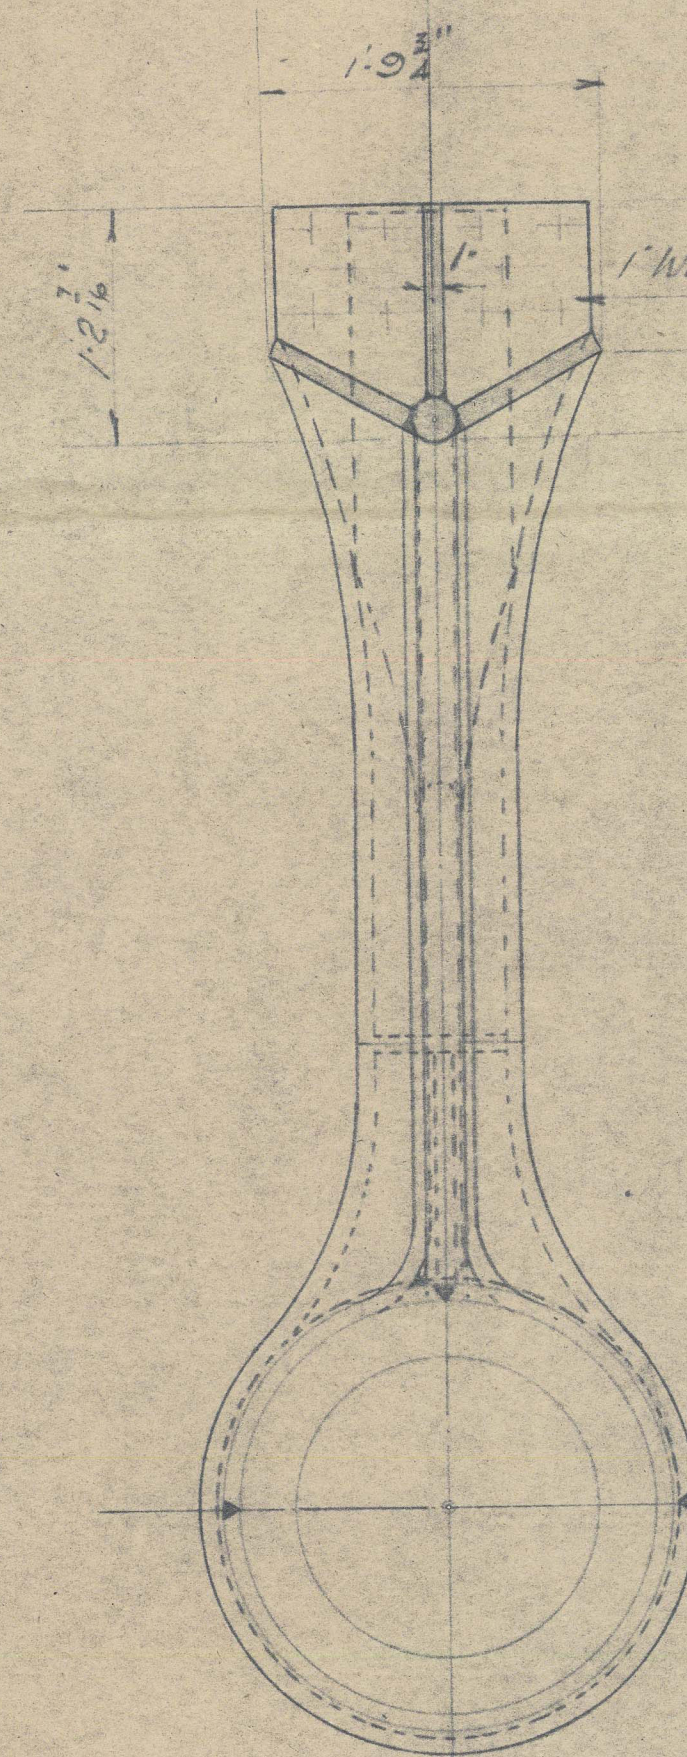


SECTION FR. 3.
LOOKING FOR

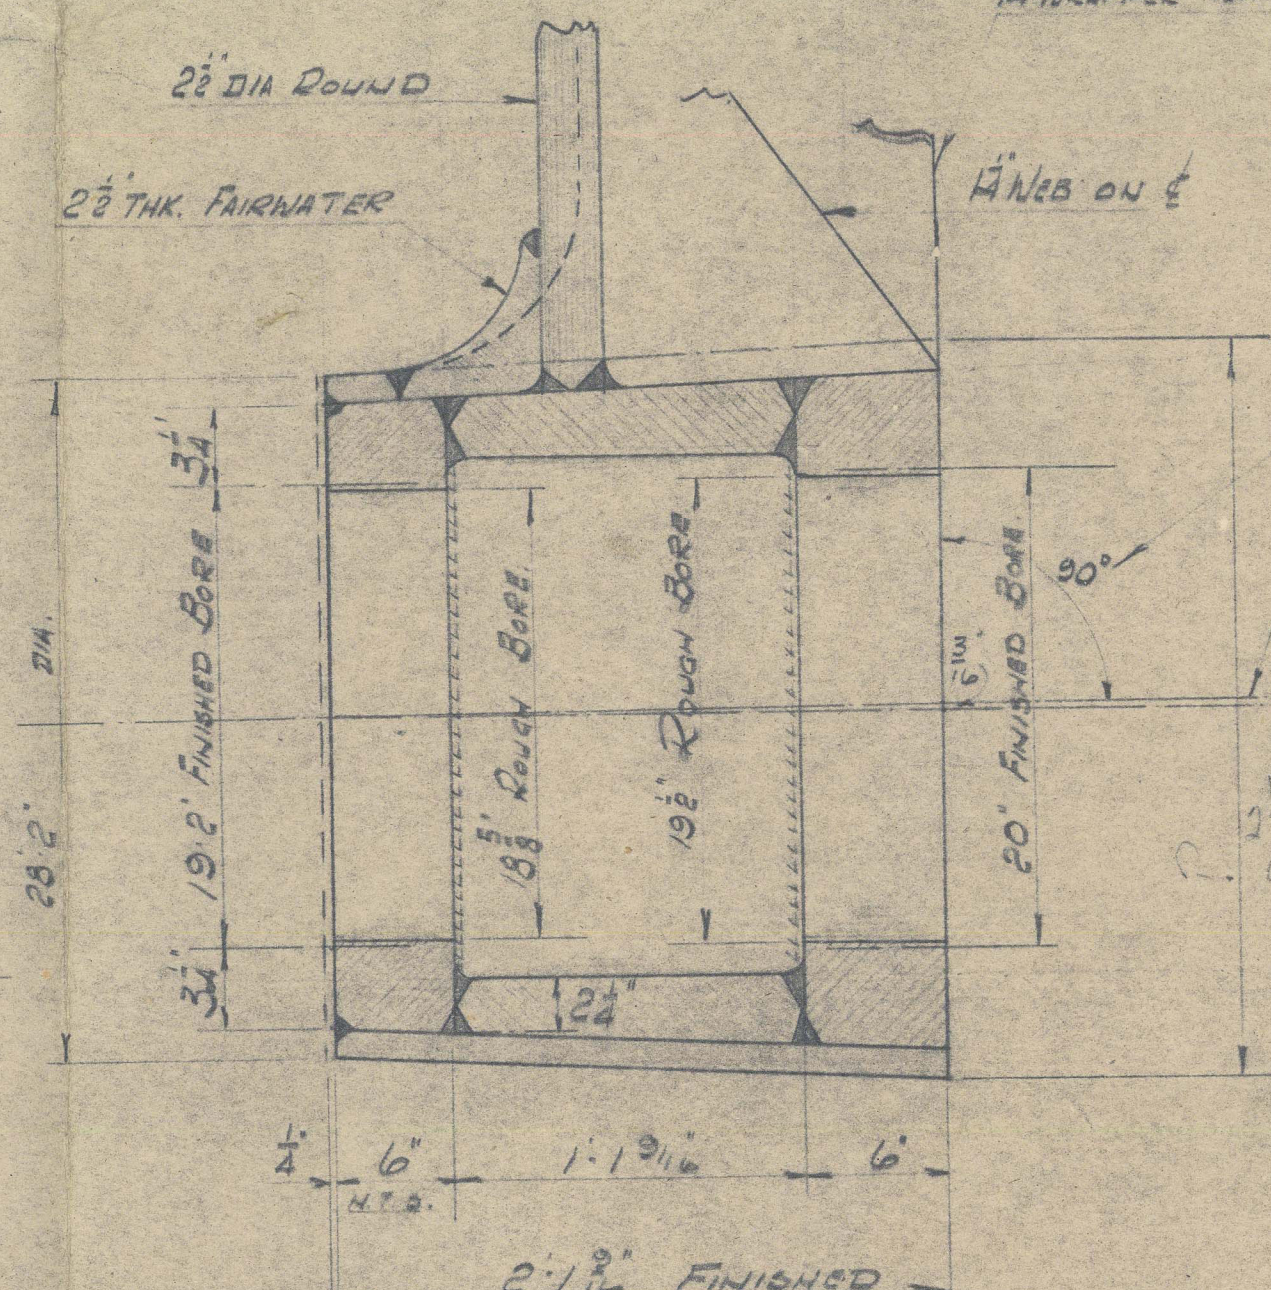



SECTION IN WAY OF PROPELLER BOSS
SCALE :- 1/2" = 1 FOOT

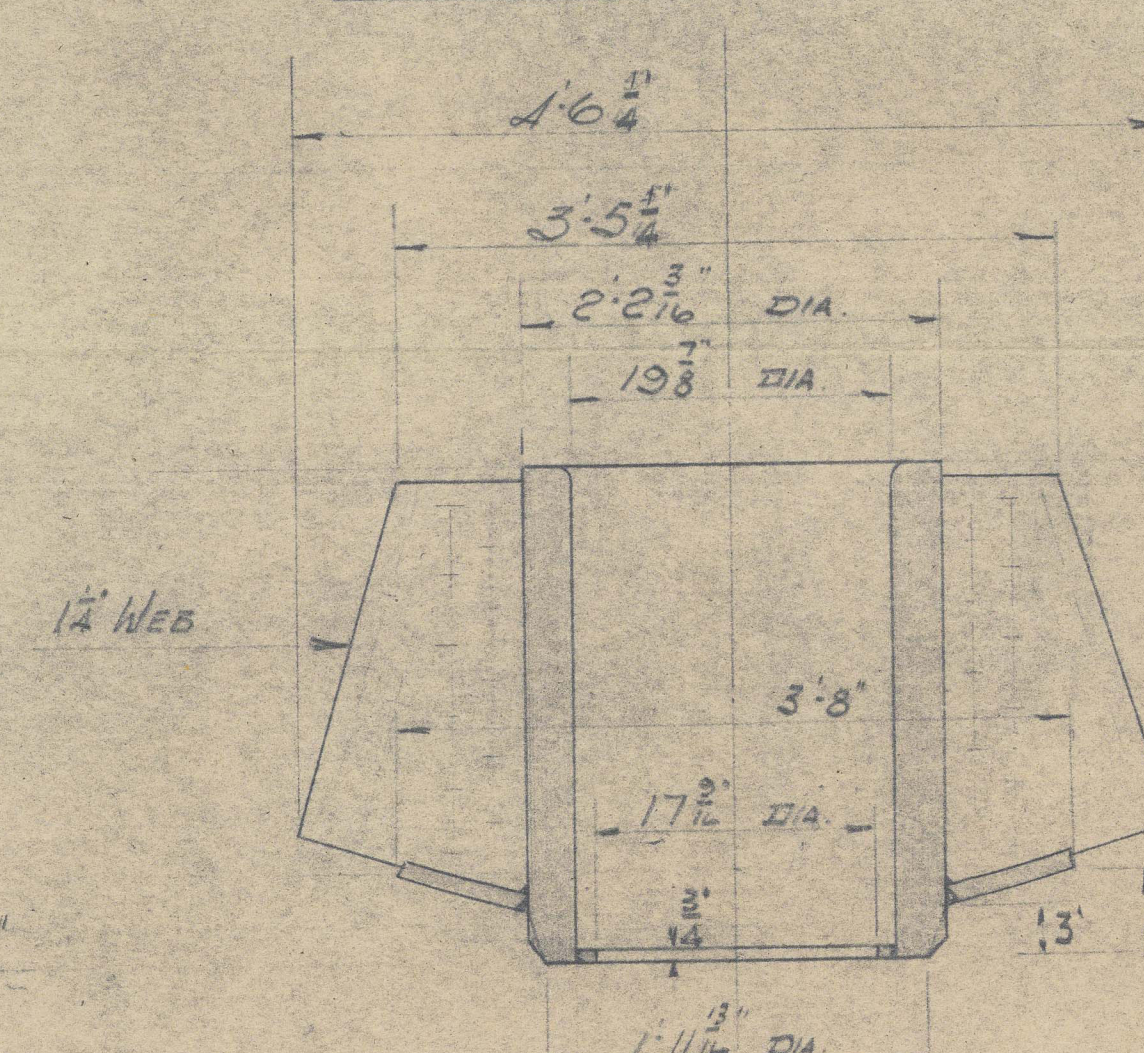


SECTION FR O & A.F.
LOOKING FBSD

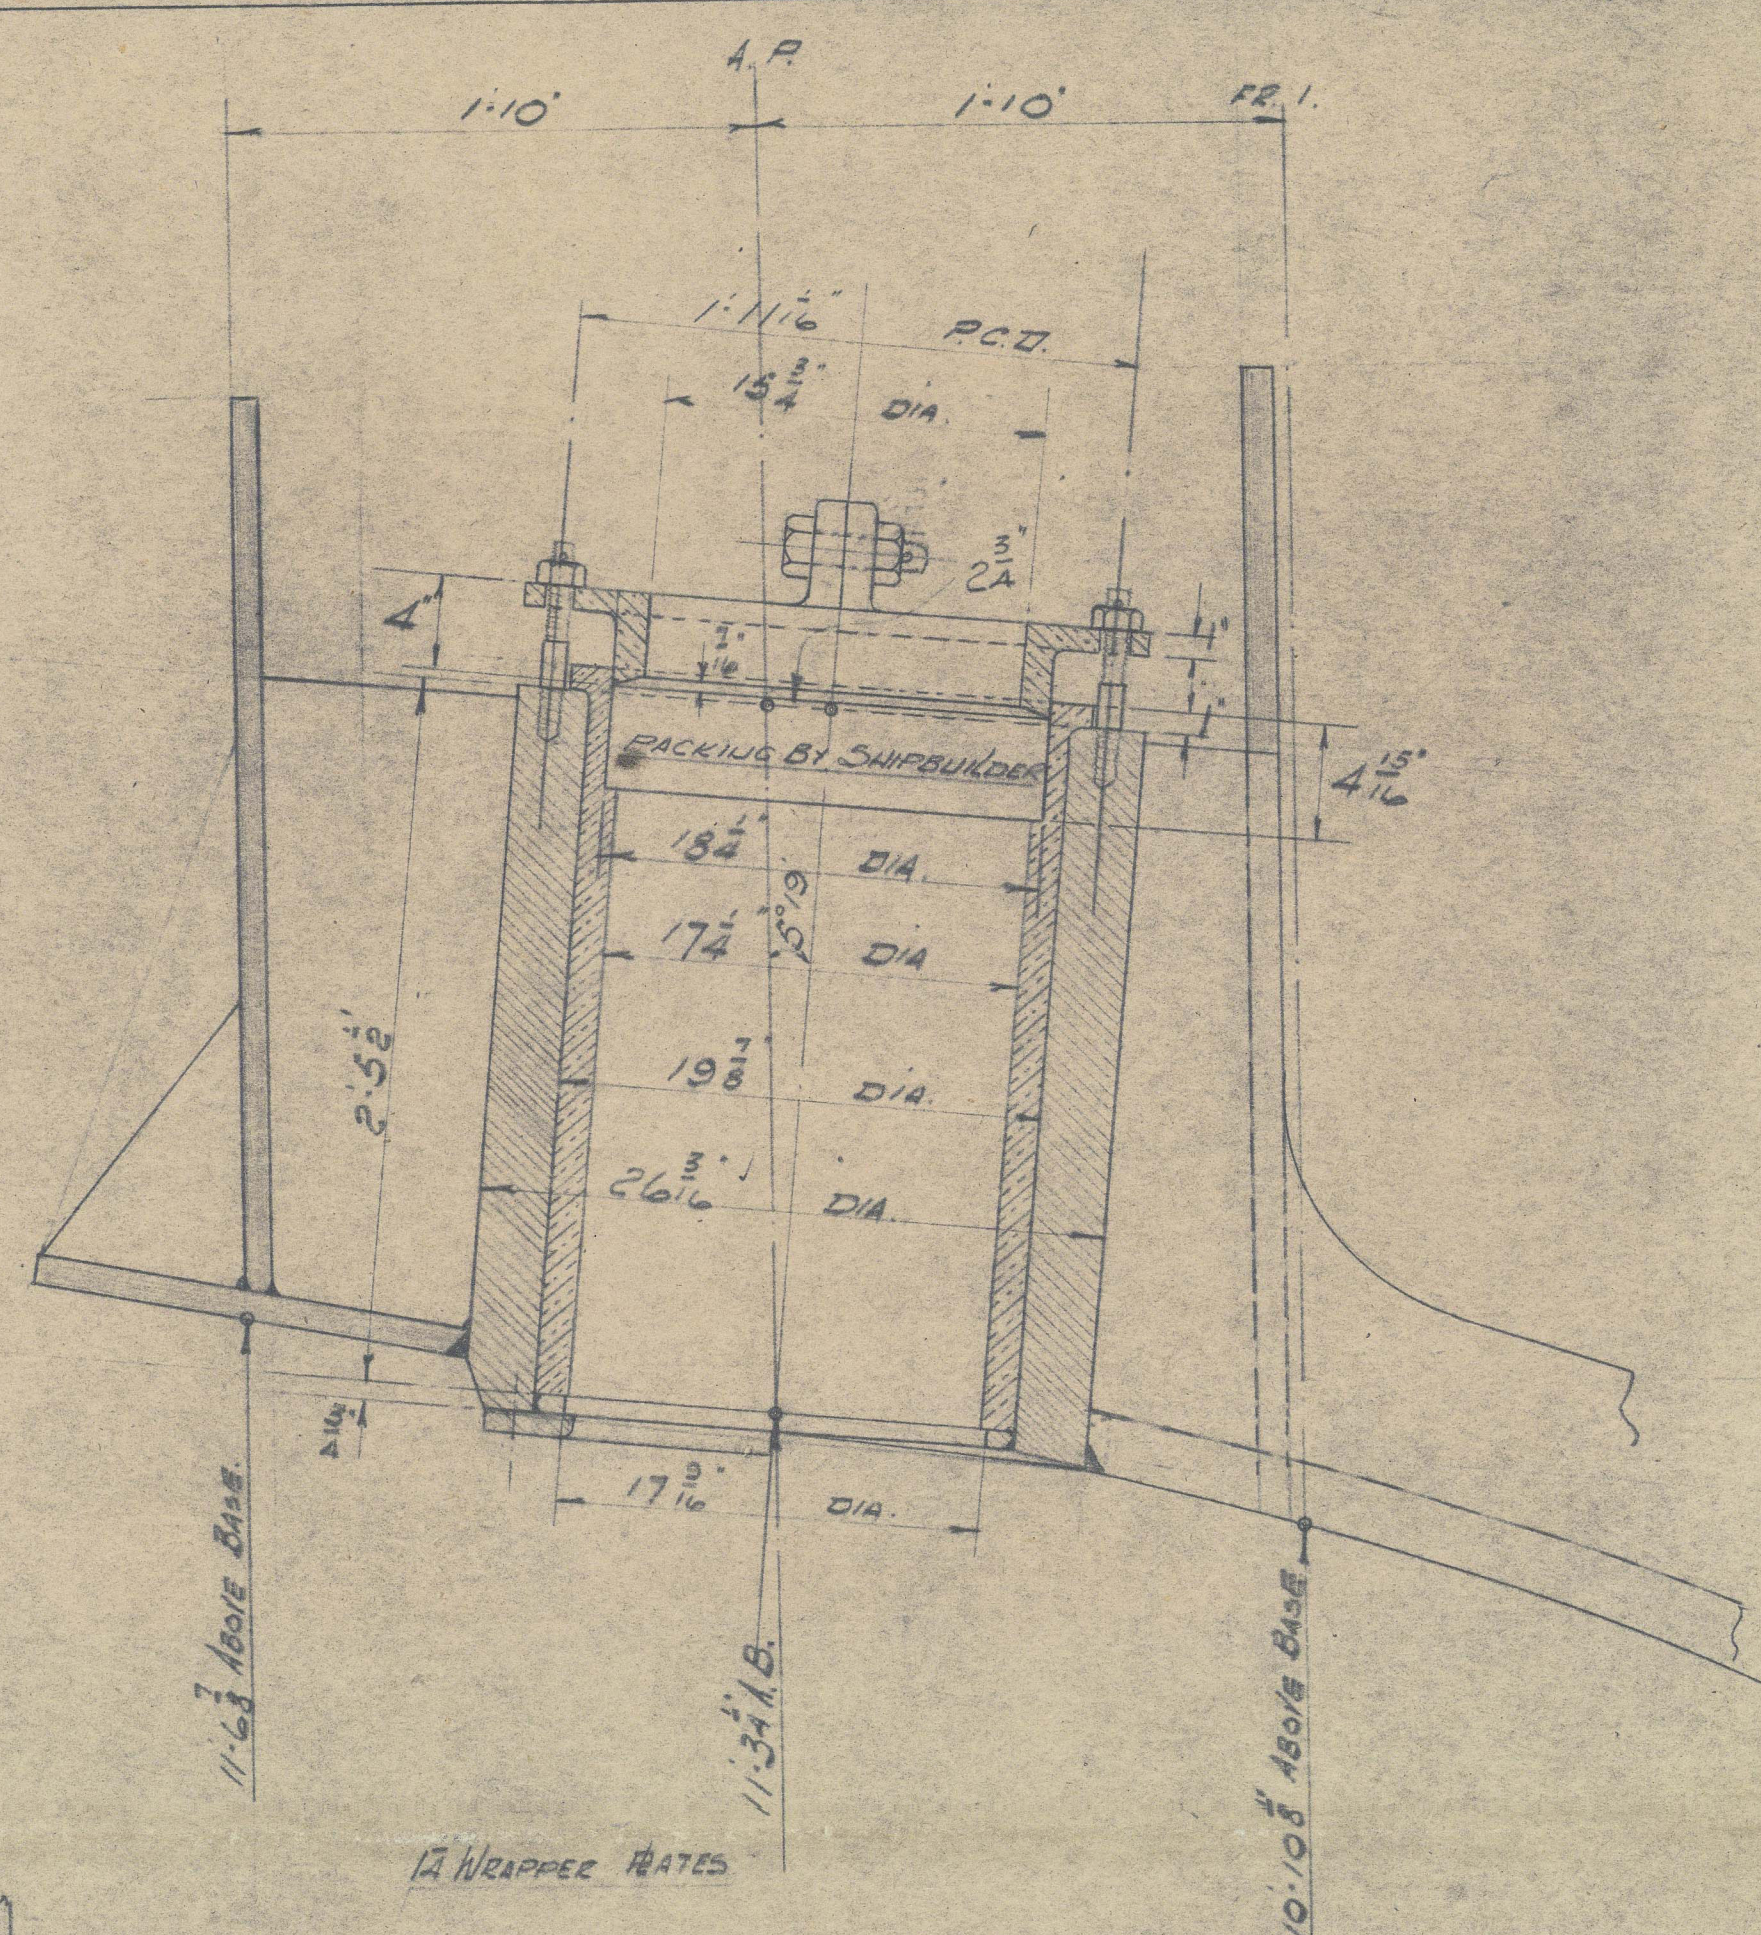


SECTION - AFT FE 1
LOOKING AFT.

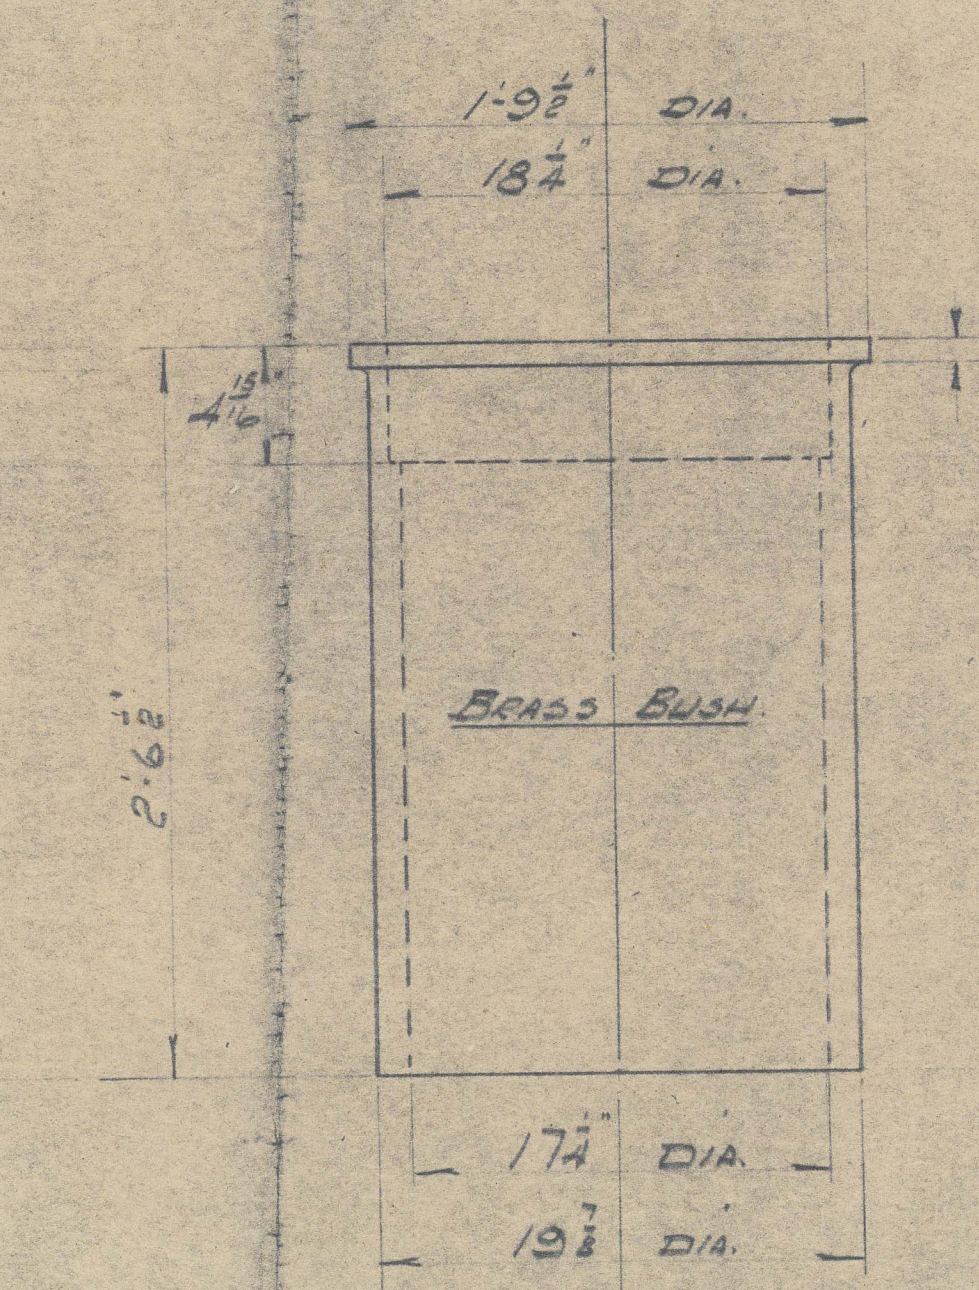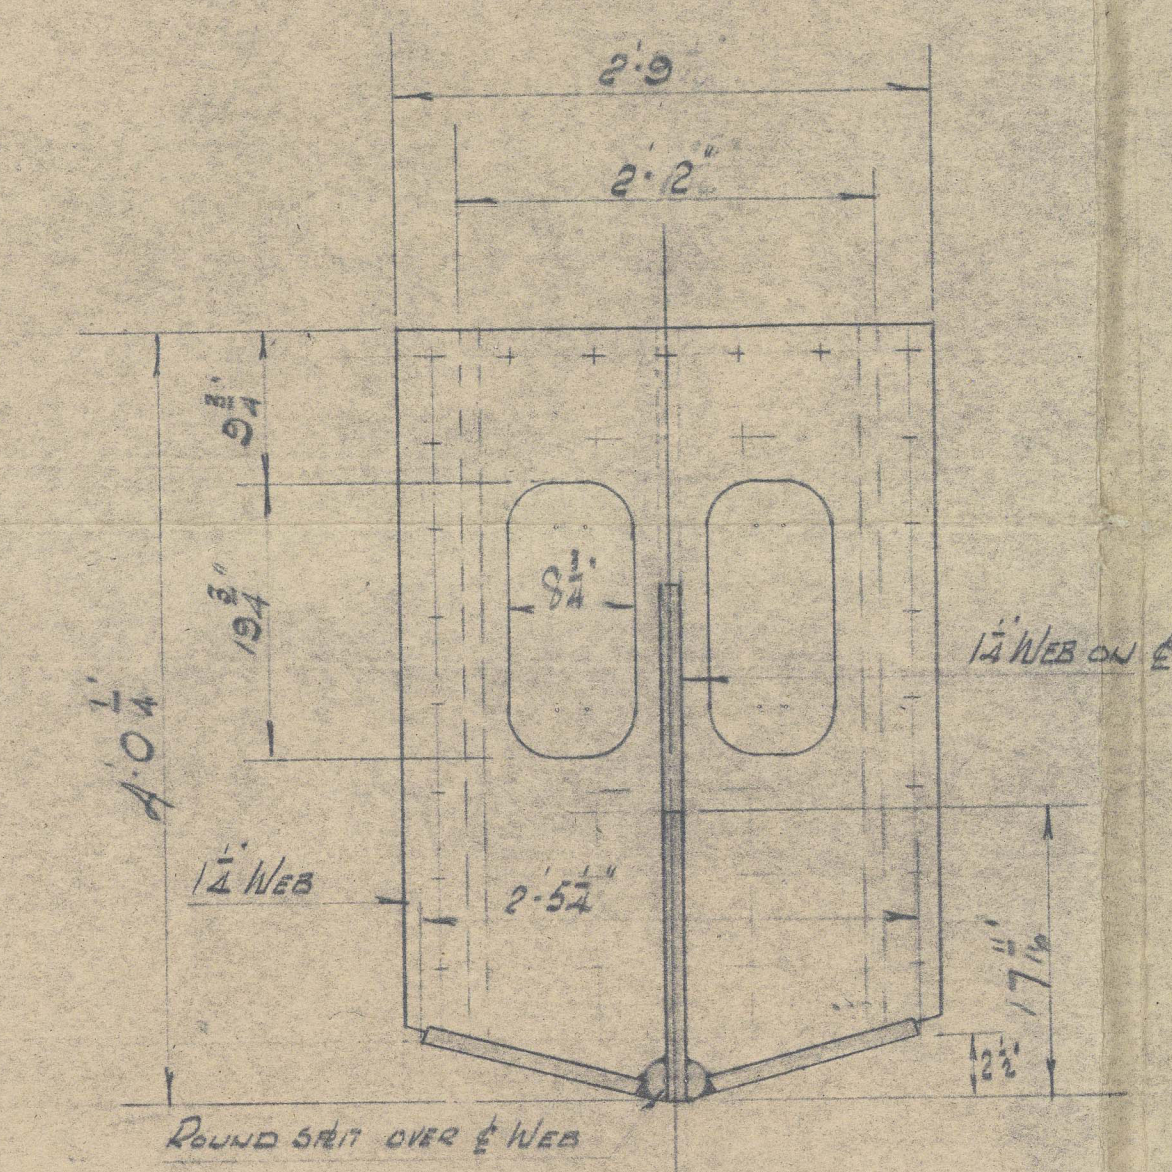

PAN VIEW.

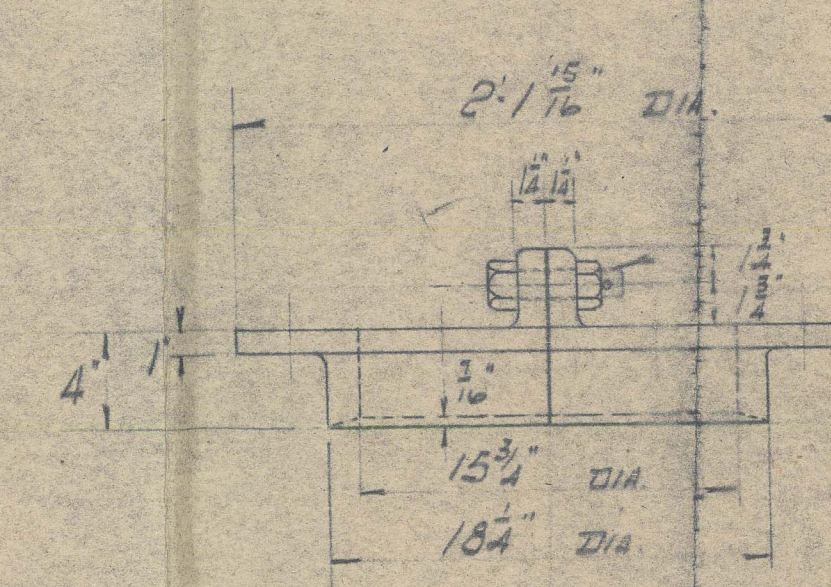

DETAIL OF G.M. GLAND

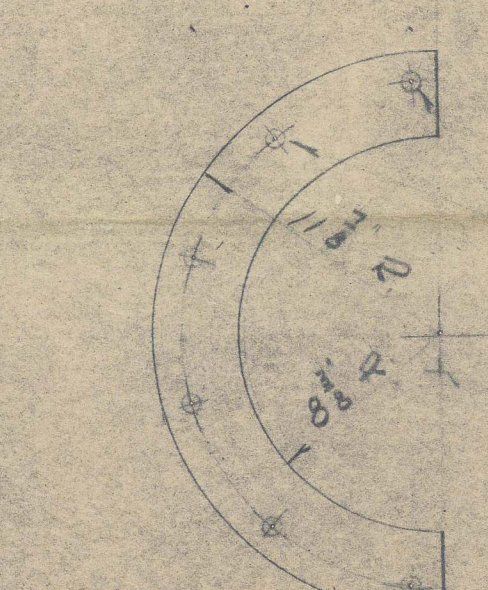

1" THK. G.M. KEEP RING.

This may not be better
 for the Oregon 22/2/92

COLVILLE CONSTRUCTIONAL COY. LTD.
GLENGARNOCK - AYLESFIRE.


Drawn	THG	Issued	50	EXHIBIT No.	4279	JOB No.	
Trace							
Checked				DRAWING No.	4279/1		

011844-011850 © 2021

RECORDS DEPT.
LONDON

5

Southern Jester
Rudder

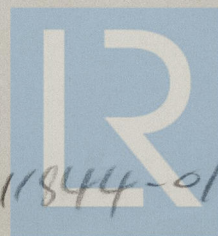

© 2021

Lloyd's Register
Foundation

011844-011850-0113

SOUTHERN JESTER


A. & J. INGLIS, LIMITED, GLASGOW.

FABRICATED RUDDERS


SHIP NOS ~~593D~~ 594D 595D 596D

TO NORSKE VERITAS REQUIREMENTS


APPROVED - 20.5.48

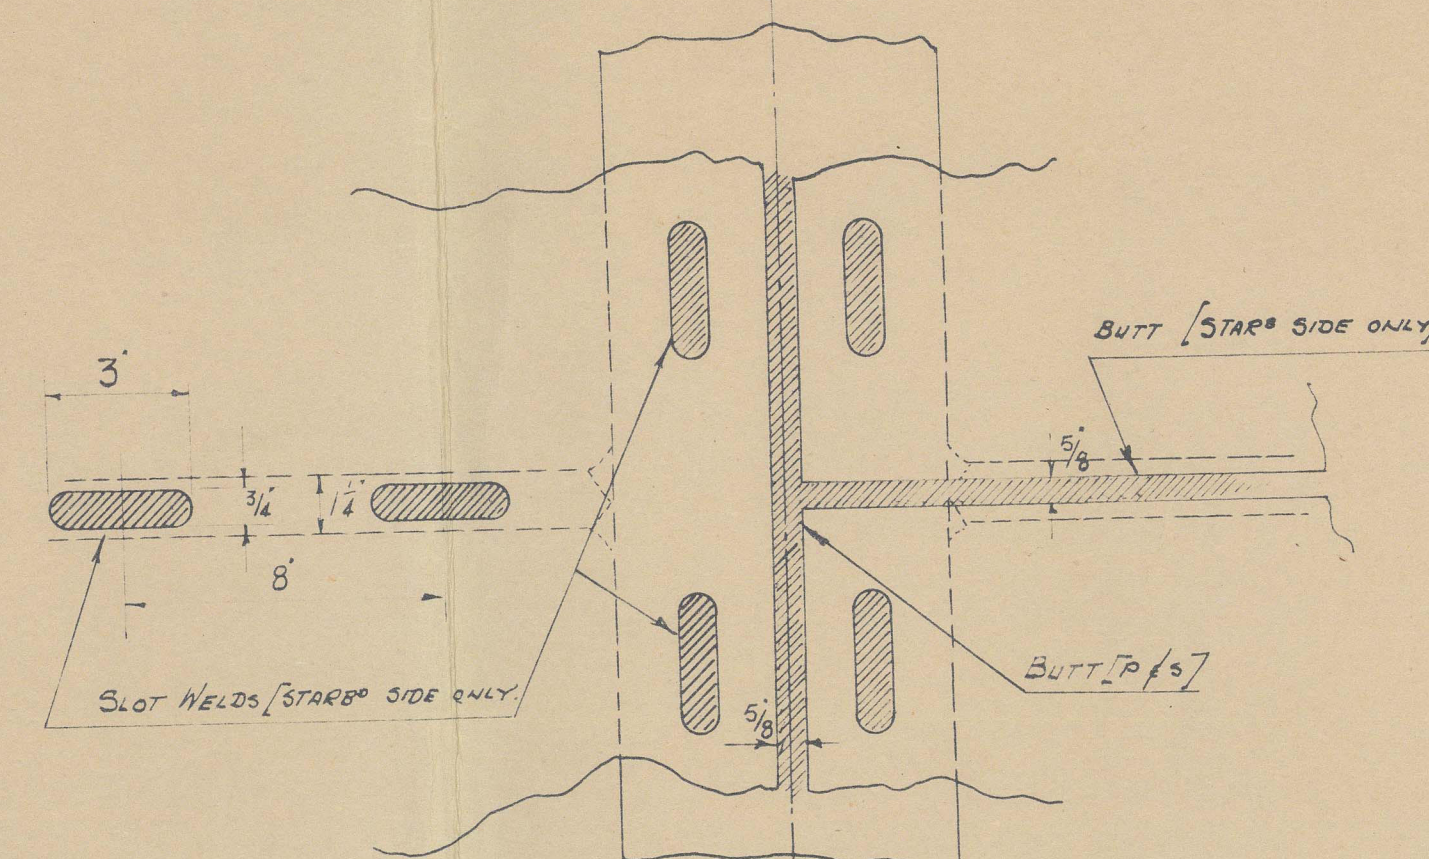

SECTIONAL PLAN VIEW
SCALE - 3" / FOOT

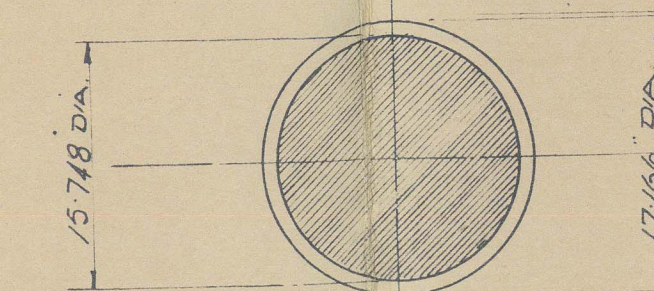


SECTION TWO STOCK
IN WAY OF BRASS BUSH

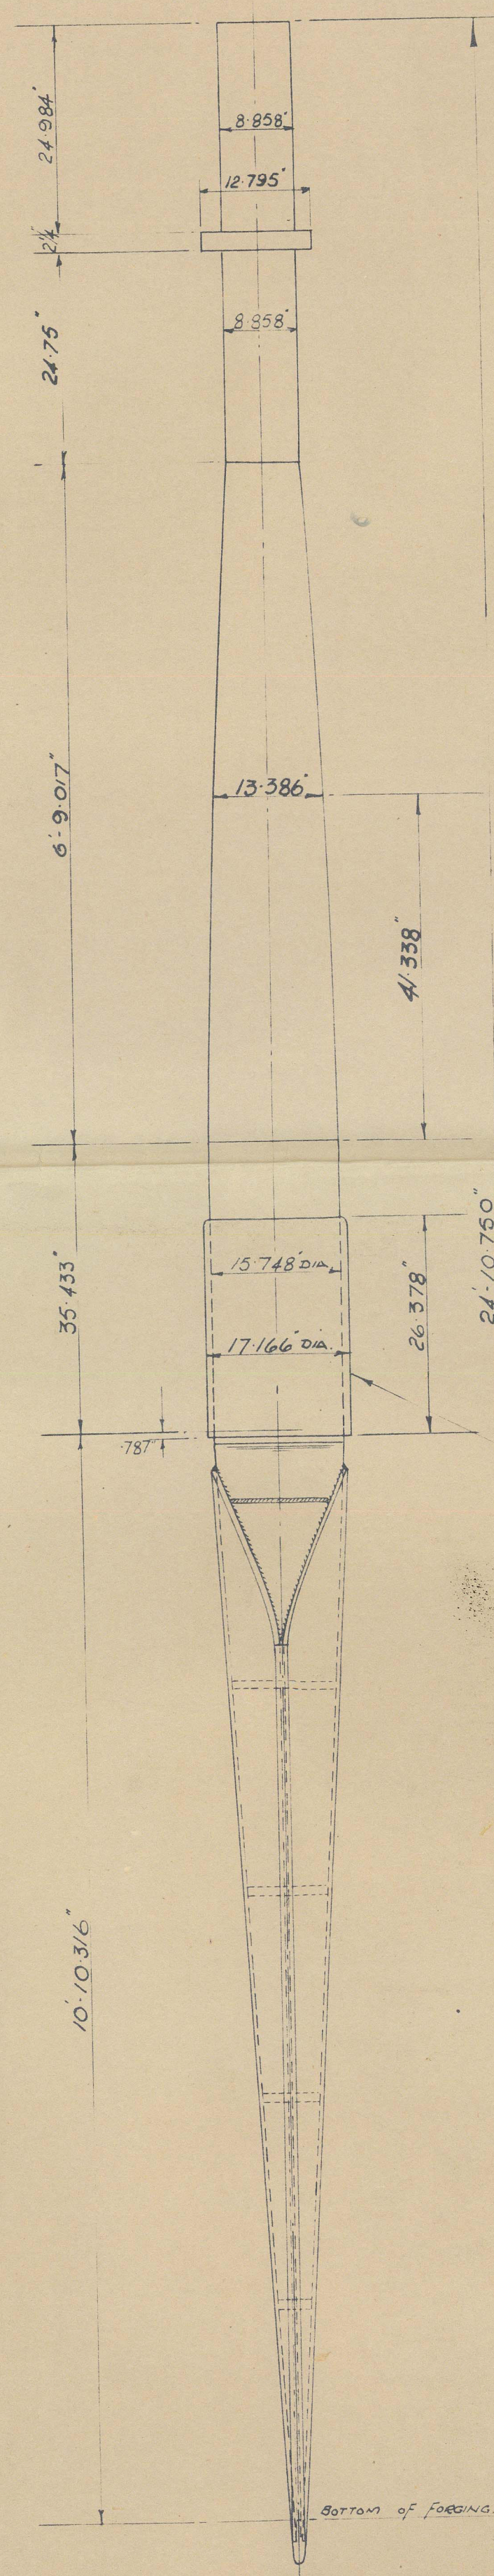


BRASS BUSH / SHOWN ON

THIS SECTION TO BE MAINTAINED
BETWEEN BUTT WELDS AT X90

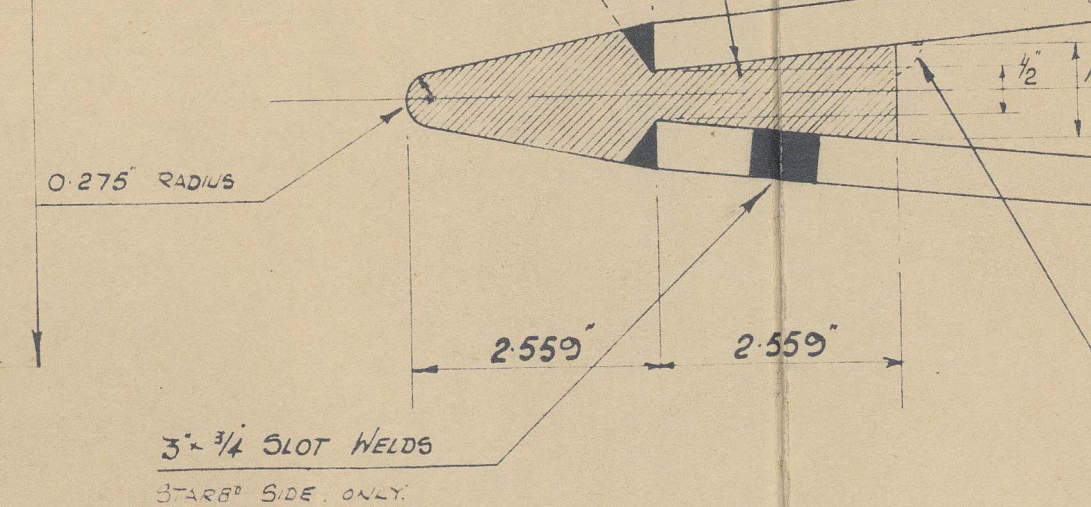


SECTION THREE TRAILING EDGE
SCALE - 1/2" FULL SIZE

STOPS AT BUTT

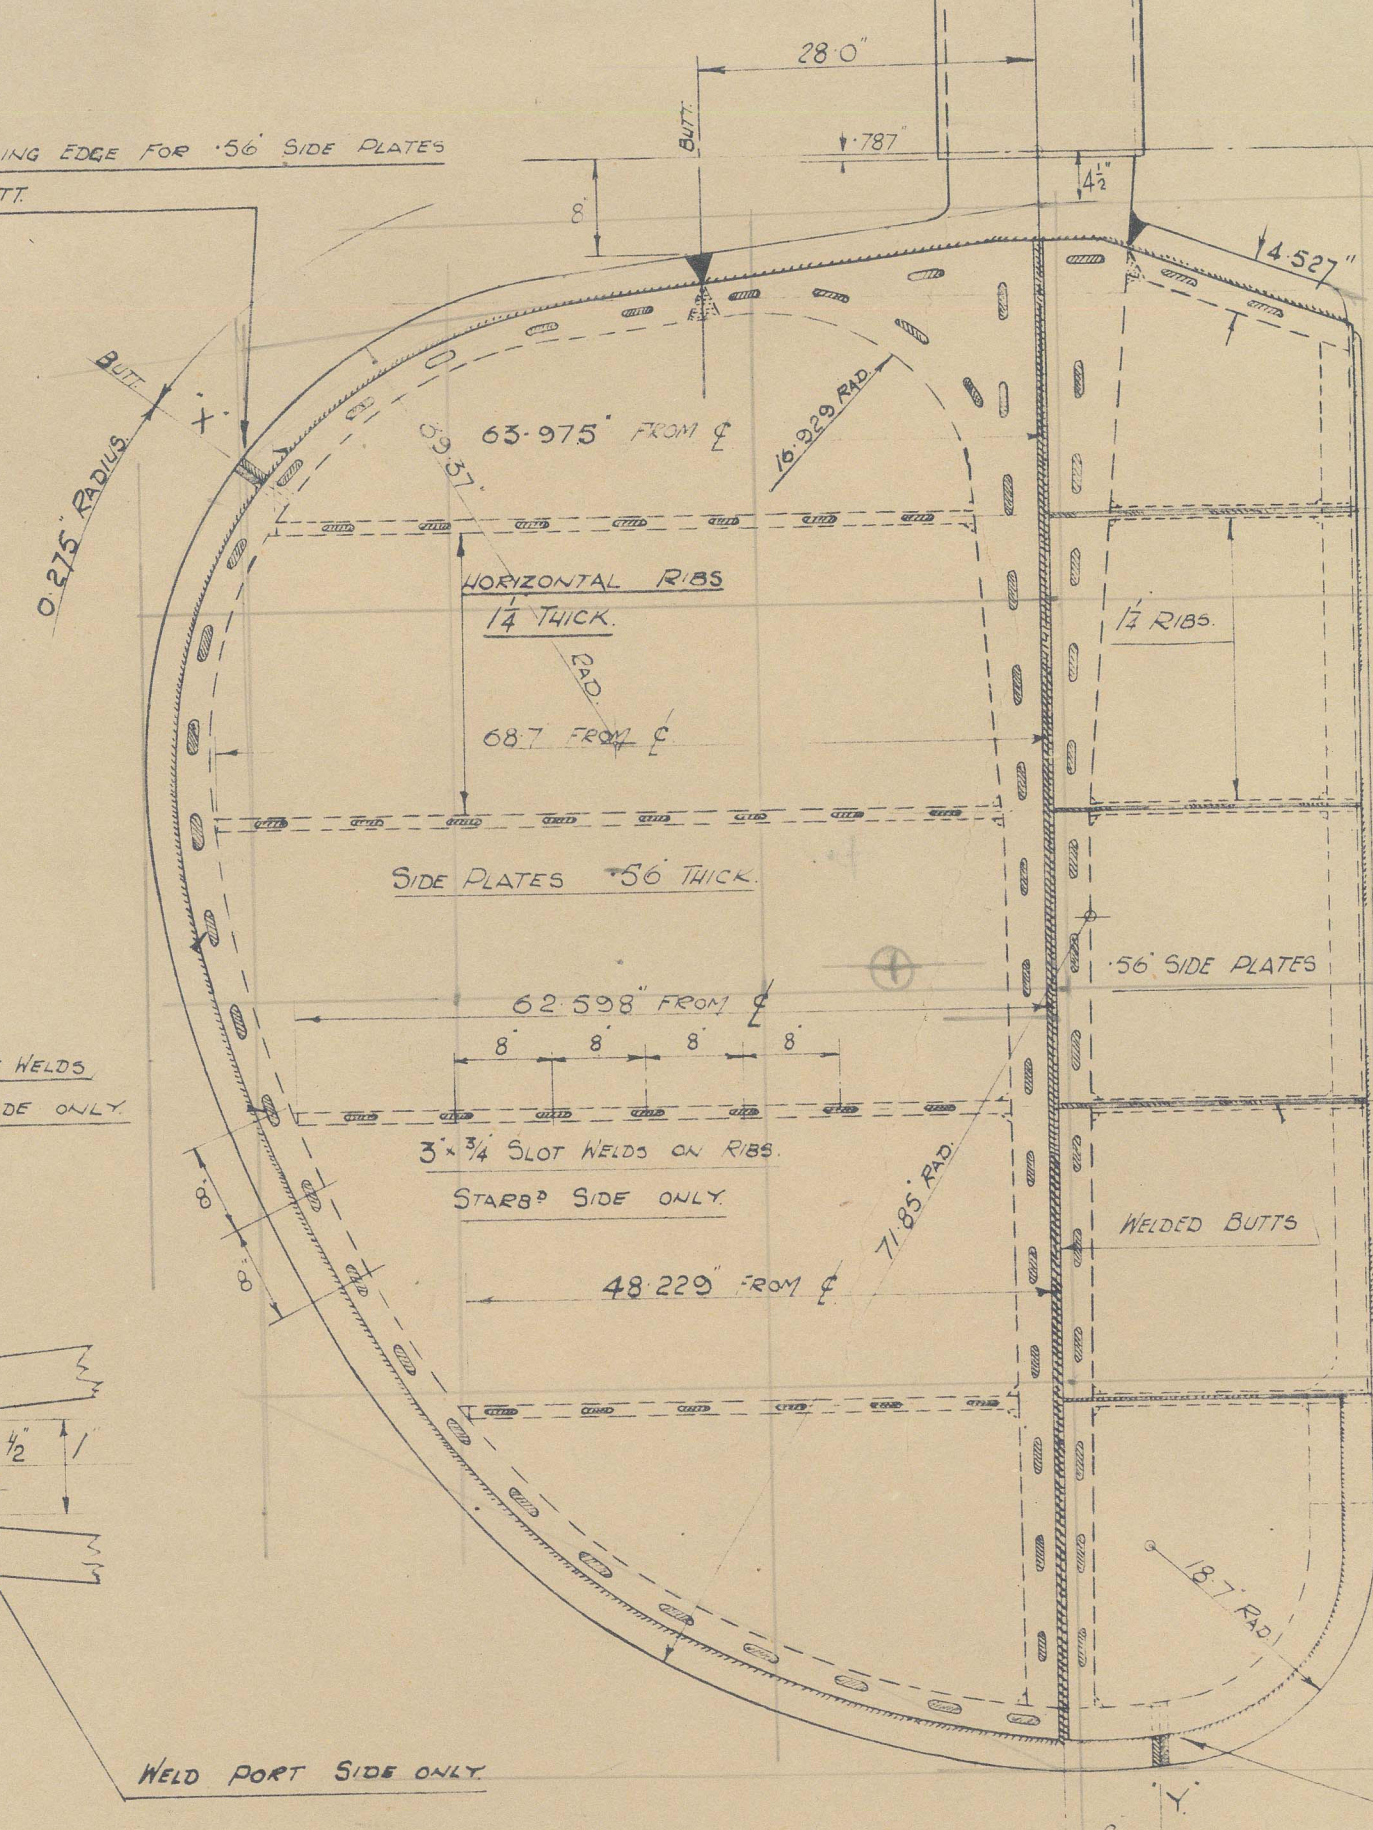

0	1	0	0
4.3	4	33.2	1
4.2	2	16.4	2
7.0	4	28.0	3
0	1	8	4
		77.6	158.0
77.6	158.0	70.6	158.0
150	77.6	5.28	
77.6	158.0	160.0	
8.4	1	8.4	0
10.9	4	43.6	1
10.2	2	20.4	2
8.3	4	26.2	3
0	1	8	4
		98.0	160.0
98.0	160.0	69.2	
150	77.6	5.32	
77.6	158.0	160.0	

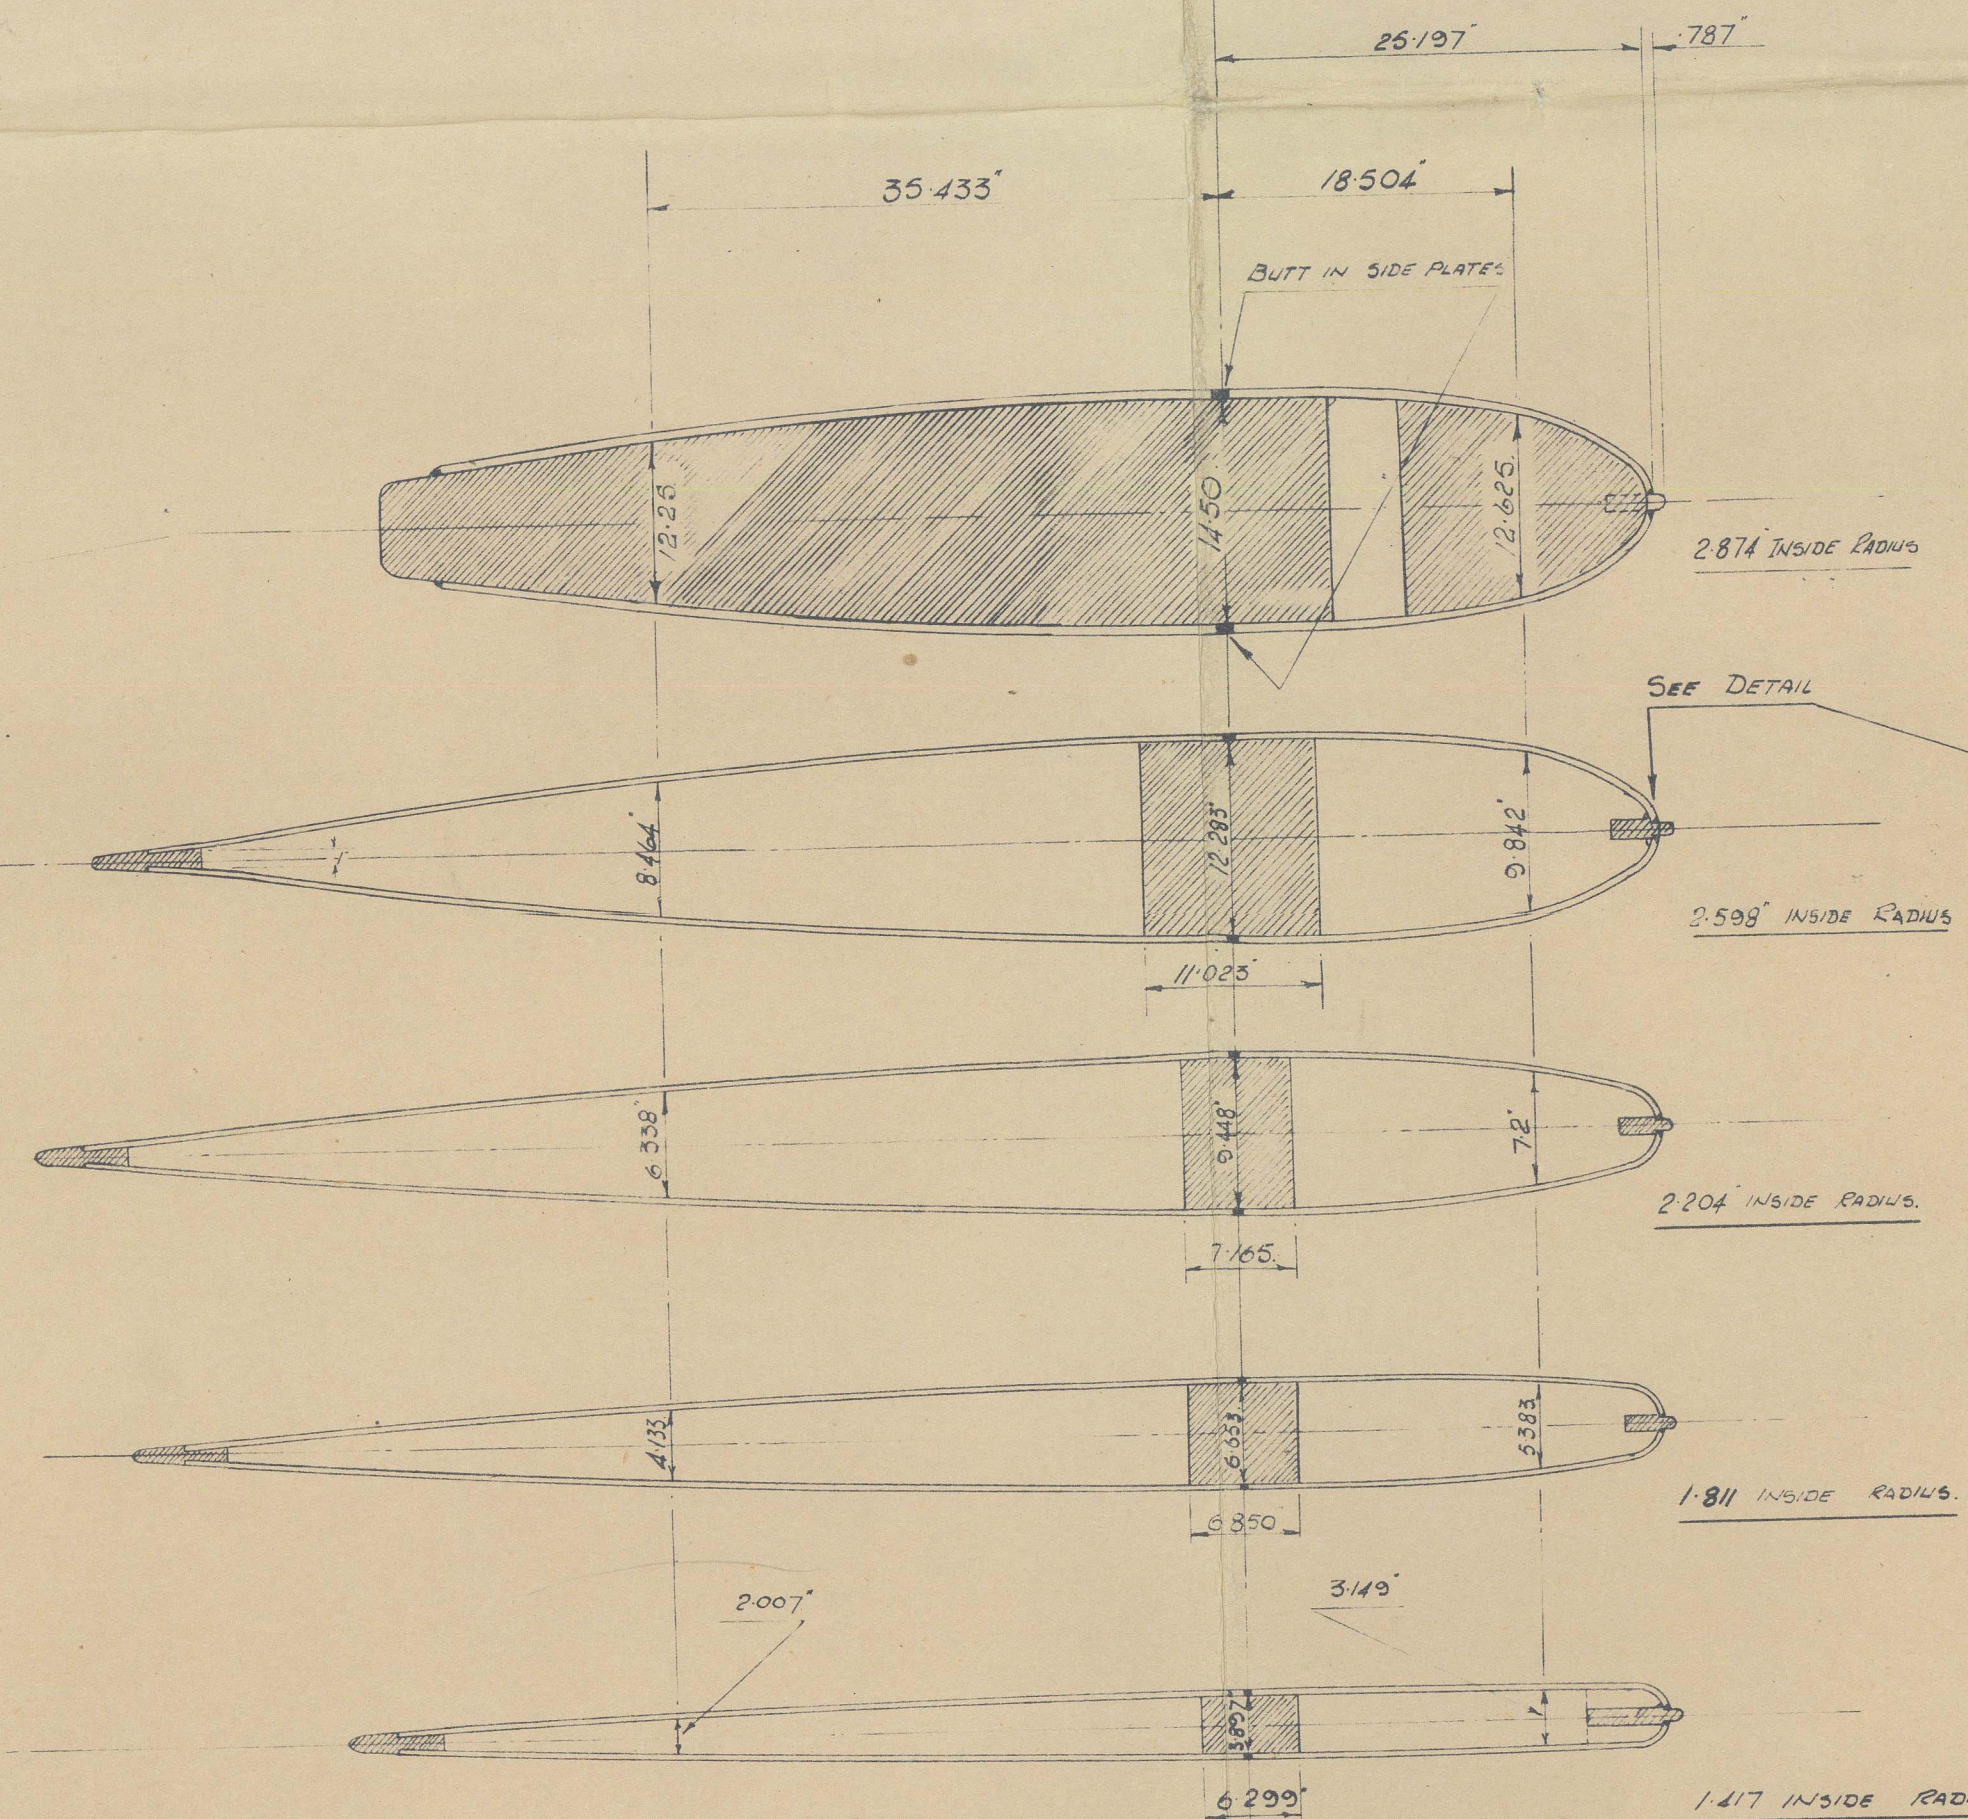

SECTIONS TWO RUDDER & STOCK
SCALE - 1" / FOOT

SECTION AT FOOT EDGE OF RUDDER
SCALE - 3" / FOOT

Office 22/8/52



A. & J. INGLIS, LIMITED, GLASGOW
FABRICATED RUDDERS.

COLVILLE CONSTRUCTION Co. Ltd.
GLASGOW - AYRSHIRE

TA 23448 5449 3449/1
3/13" / FOOT

011 544-011 550-011 551